


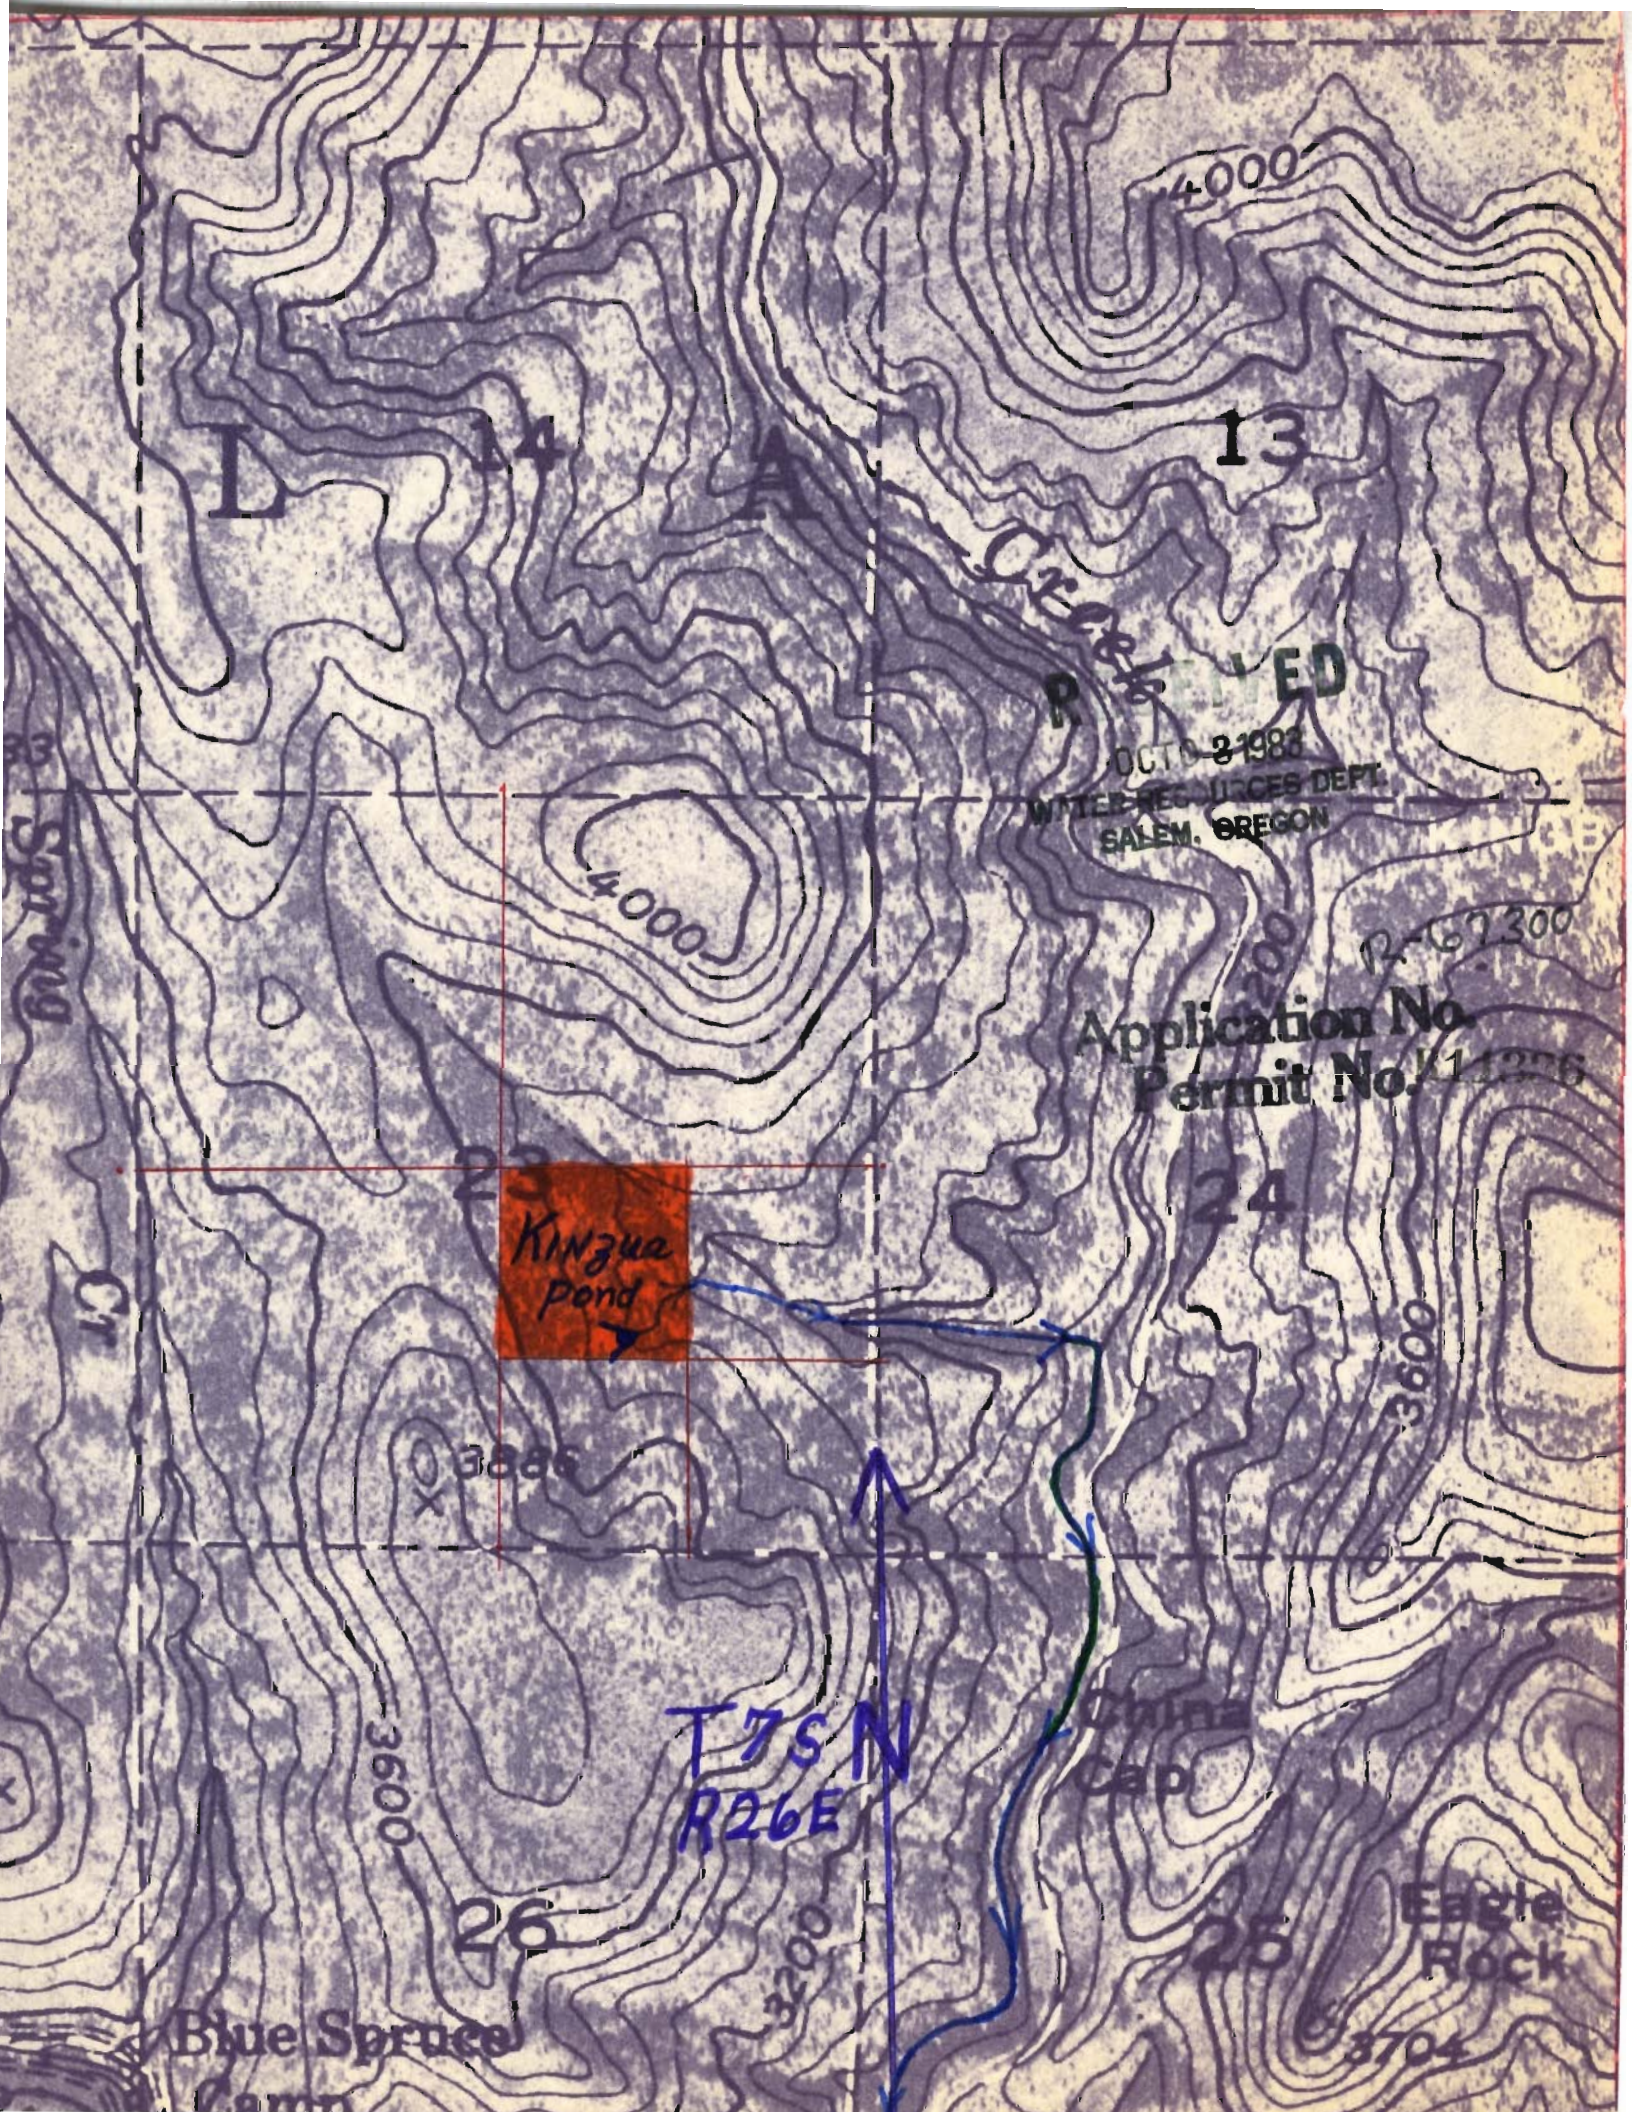

L

14

13

4000

4000

REVISED

OCTO 21 1983

WATER RESOURCES DEPT.
SALEM, OREGON

R-67300

Application No.
Permit No. 11256

24

Kinzua pond

23

3886

3600

T7S N
R26E

China Cap

26

25

Eagle Rock

3704

Blue Spruce Camp

Spring

Cr