


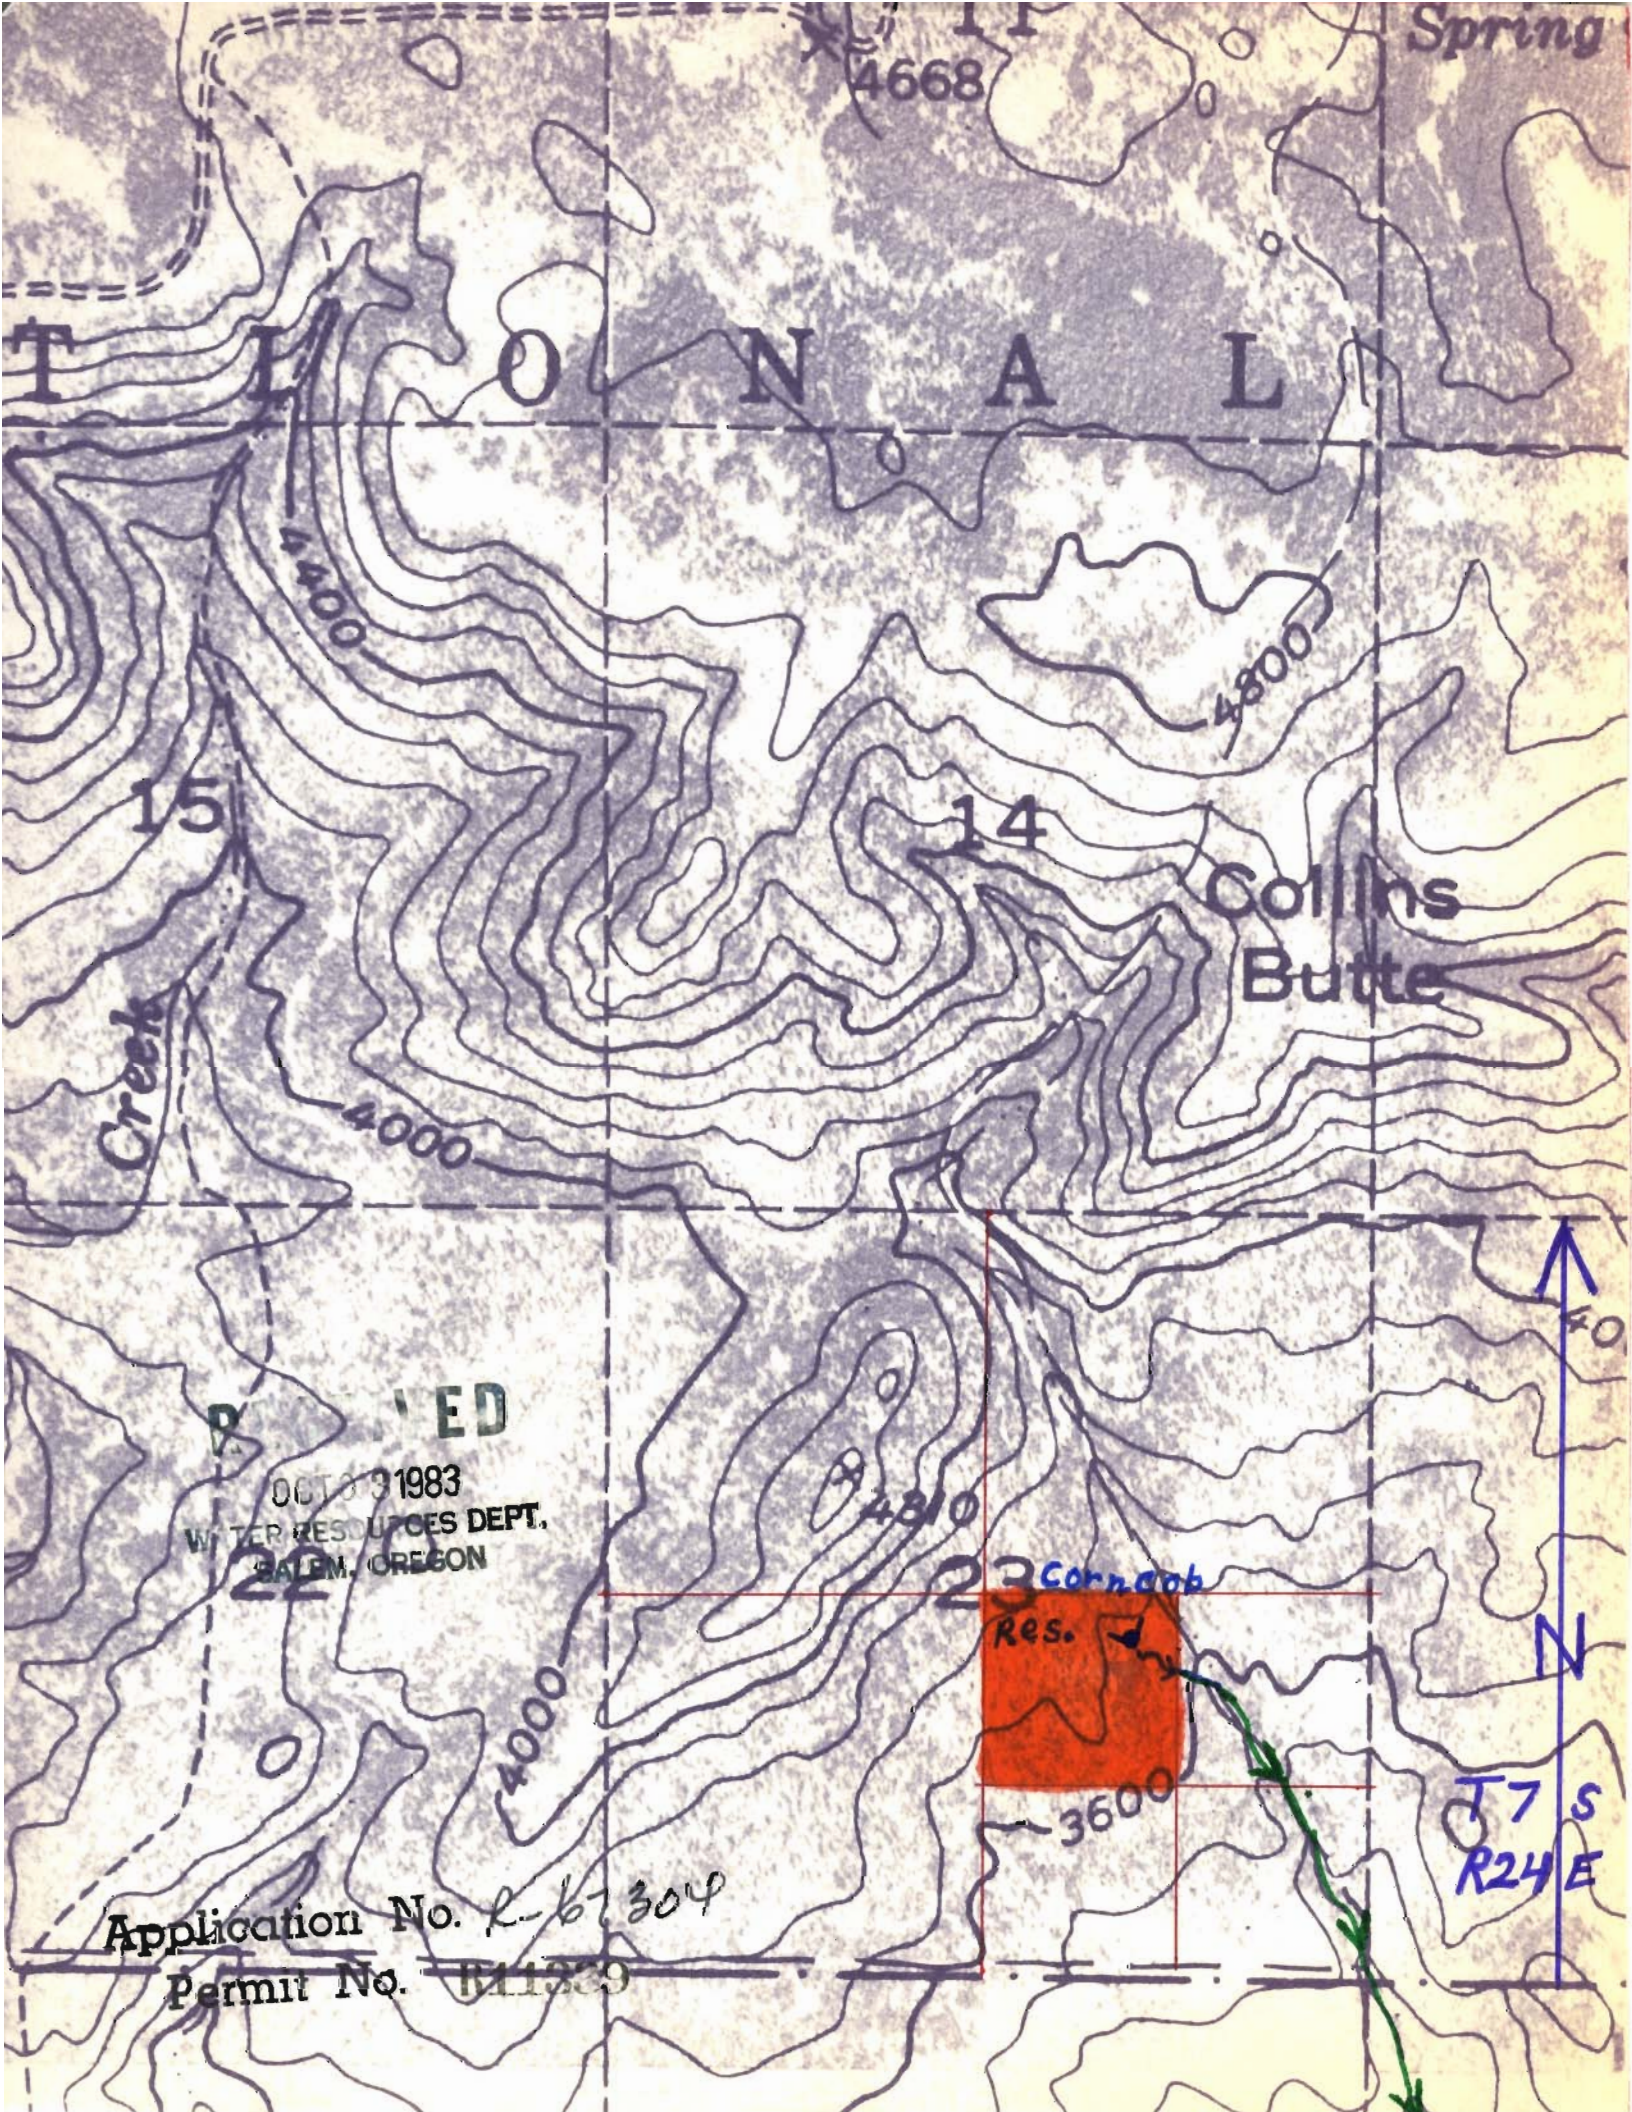

Spring

4668

T E O N A L

Collins Butte

Creek

RECEIVED
OCT 3 1983
WATER RESOURCES DEPT.
SALEM, OREGON

Corn Cob Res.

T7 S
R24 E

Application No. R-67304
Permit No. R41329