


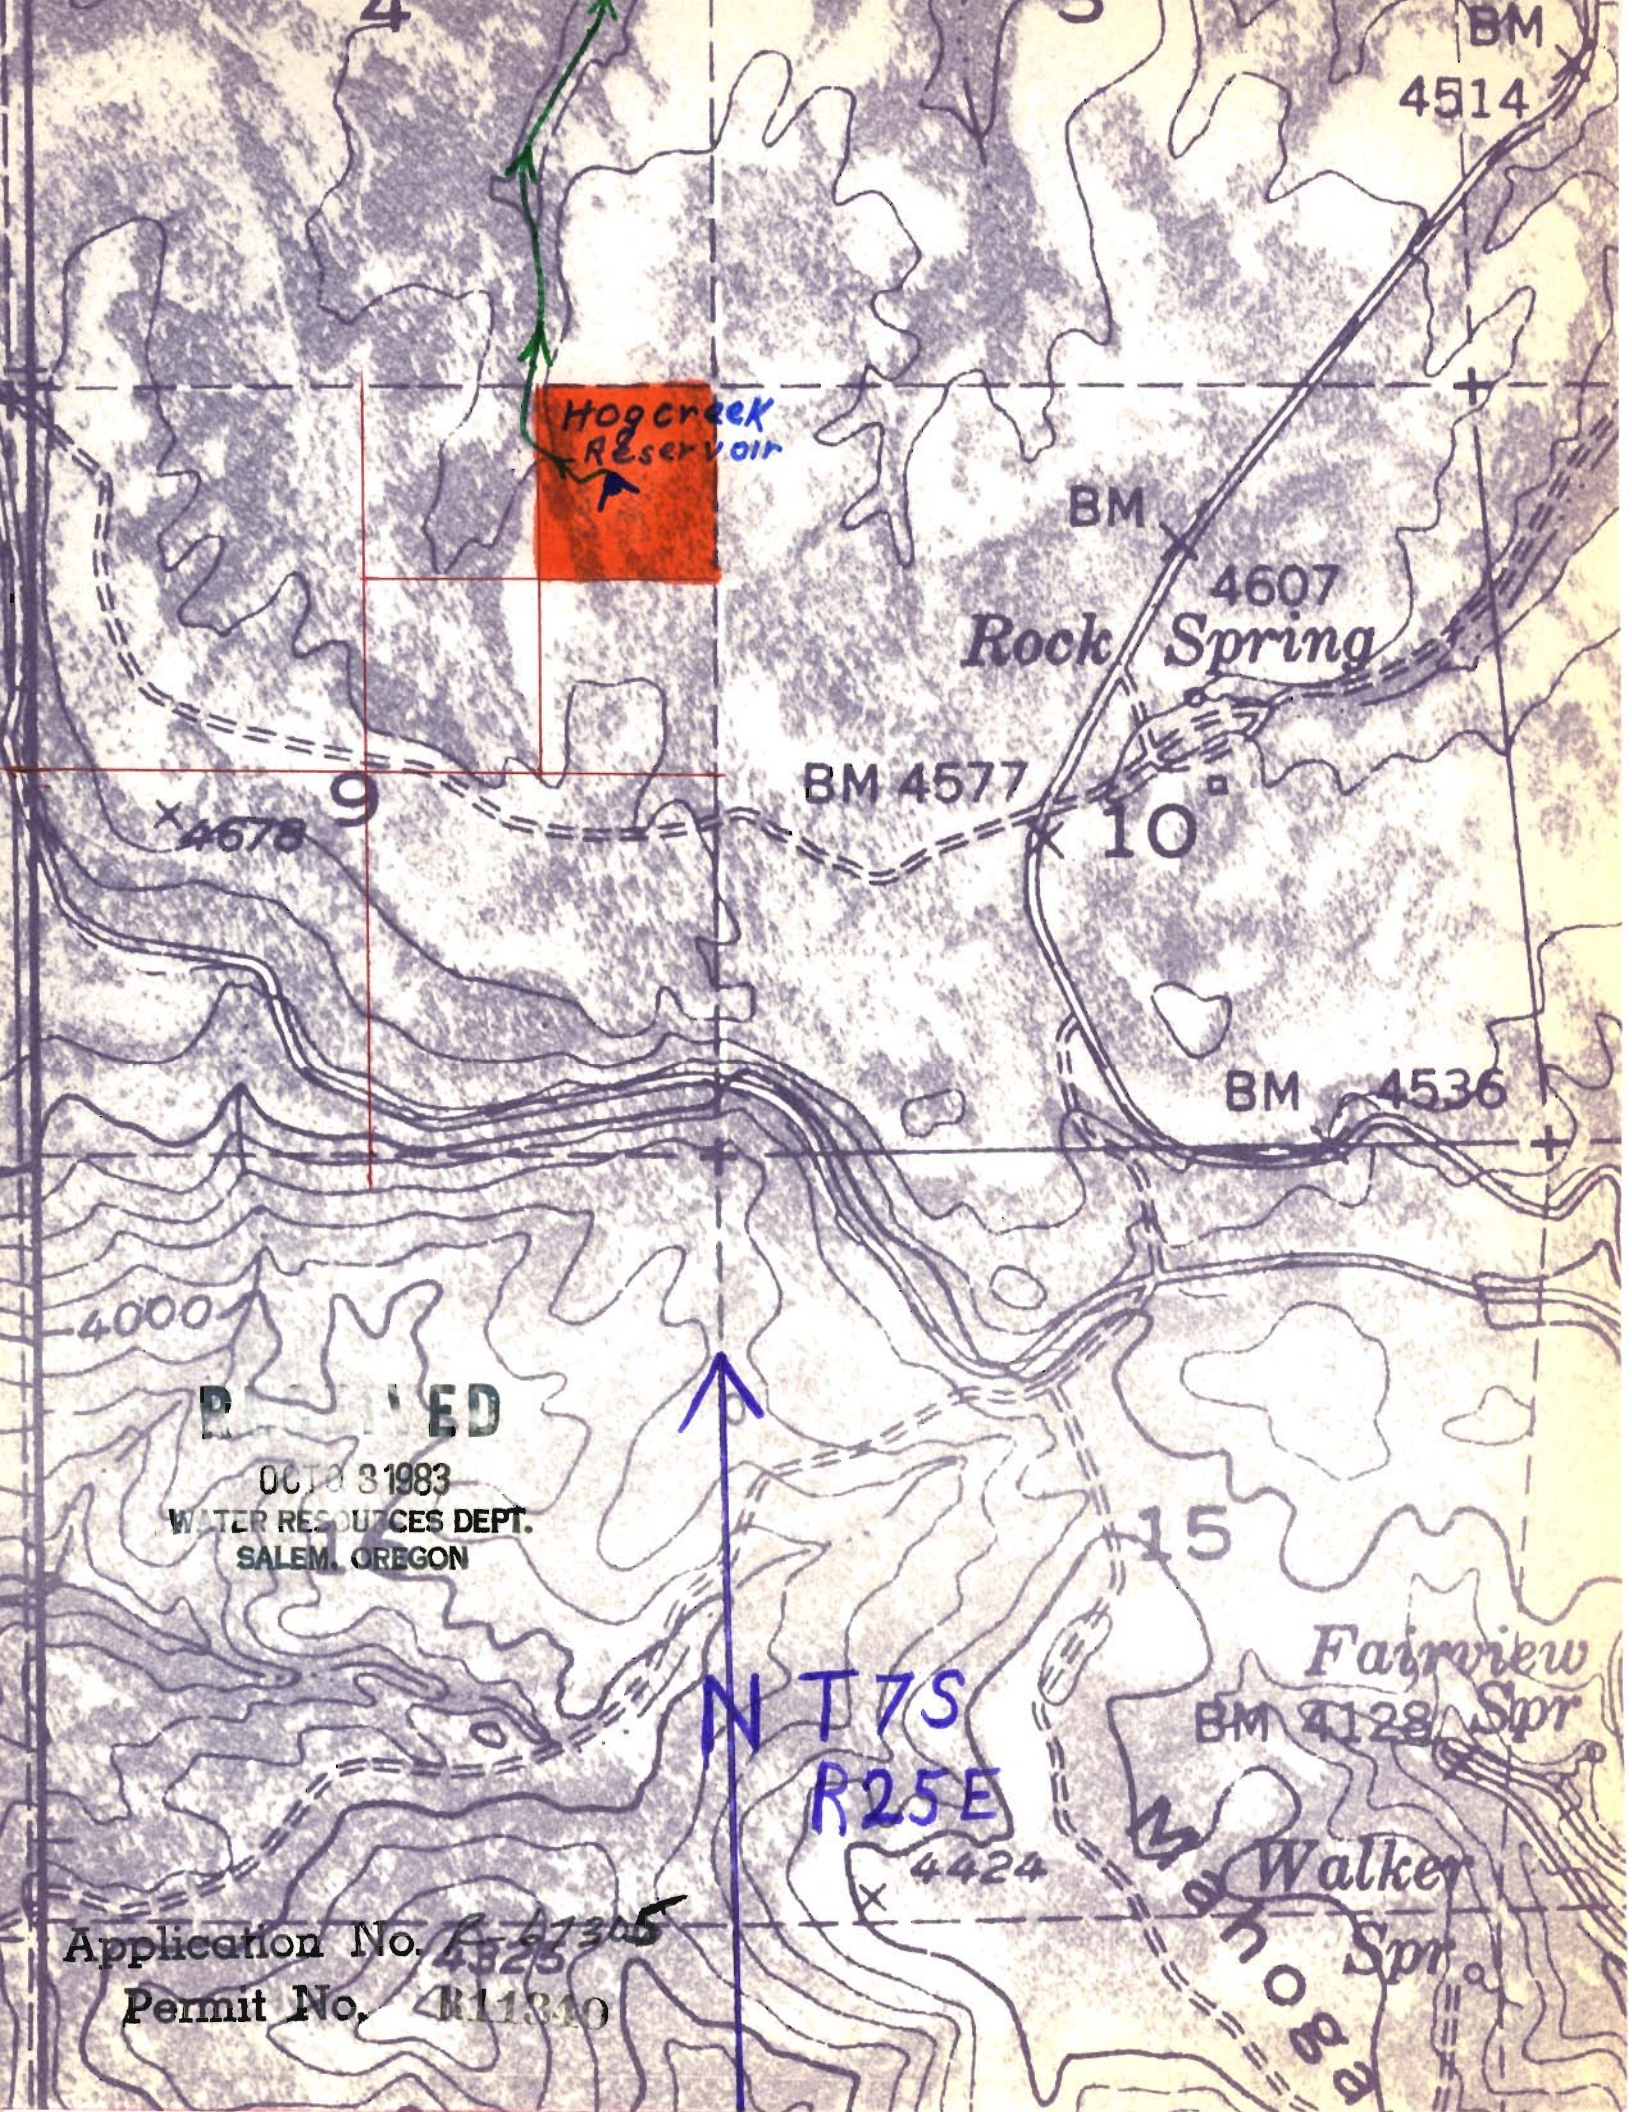

Hog Creek
Reservoir

BM
4514

BM

4607

Rock Spring

BM 4577

10

BM 4536

4000

RECEIVED

OCT 31 1983

WATER RESOURCES DEPT.
SALEM, OREGON

N T 7 S
R 25 E

15

Fairview
BM 4128 Spr

4424

Walker
Spr

Application No. ~~4323~~ 47305

Permit No. R11310