

TOWNSHIP 75, RANGE 26 E, SECTION 12, W.M.

11

12

PVT


14

13

NAME Clarks Corner Pond COUNTY GRANT

Application No. **R67422**
Permit No. **R11356**

RECEIVED
OCT 17 1983
WATER RESOURCES DEPT.
SALEM, OREGON

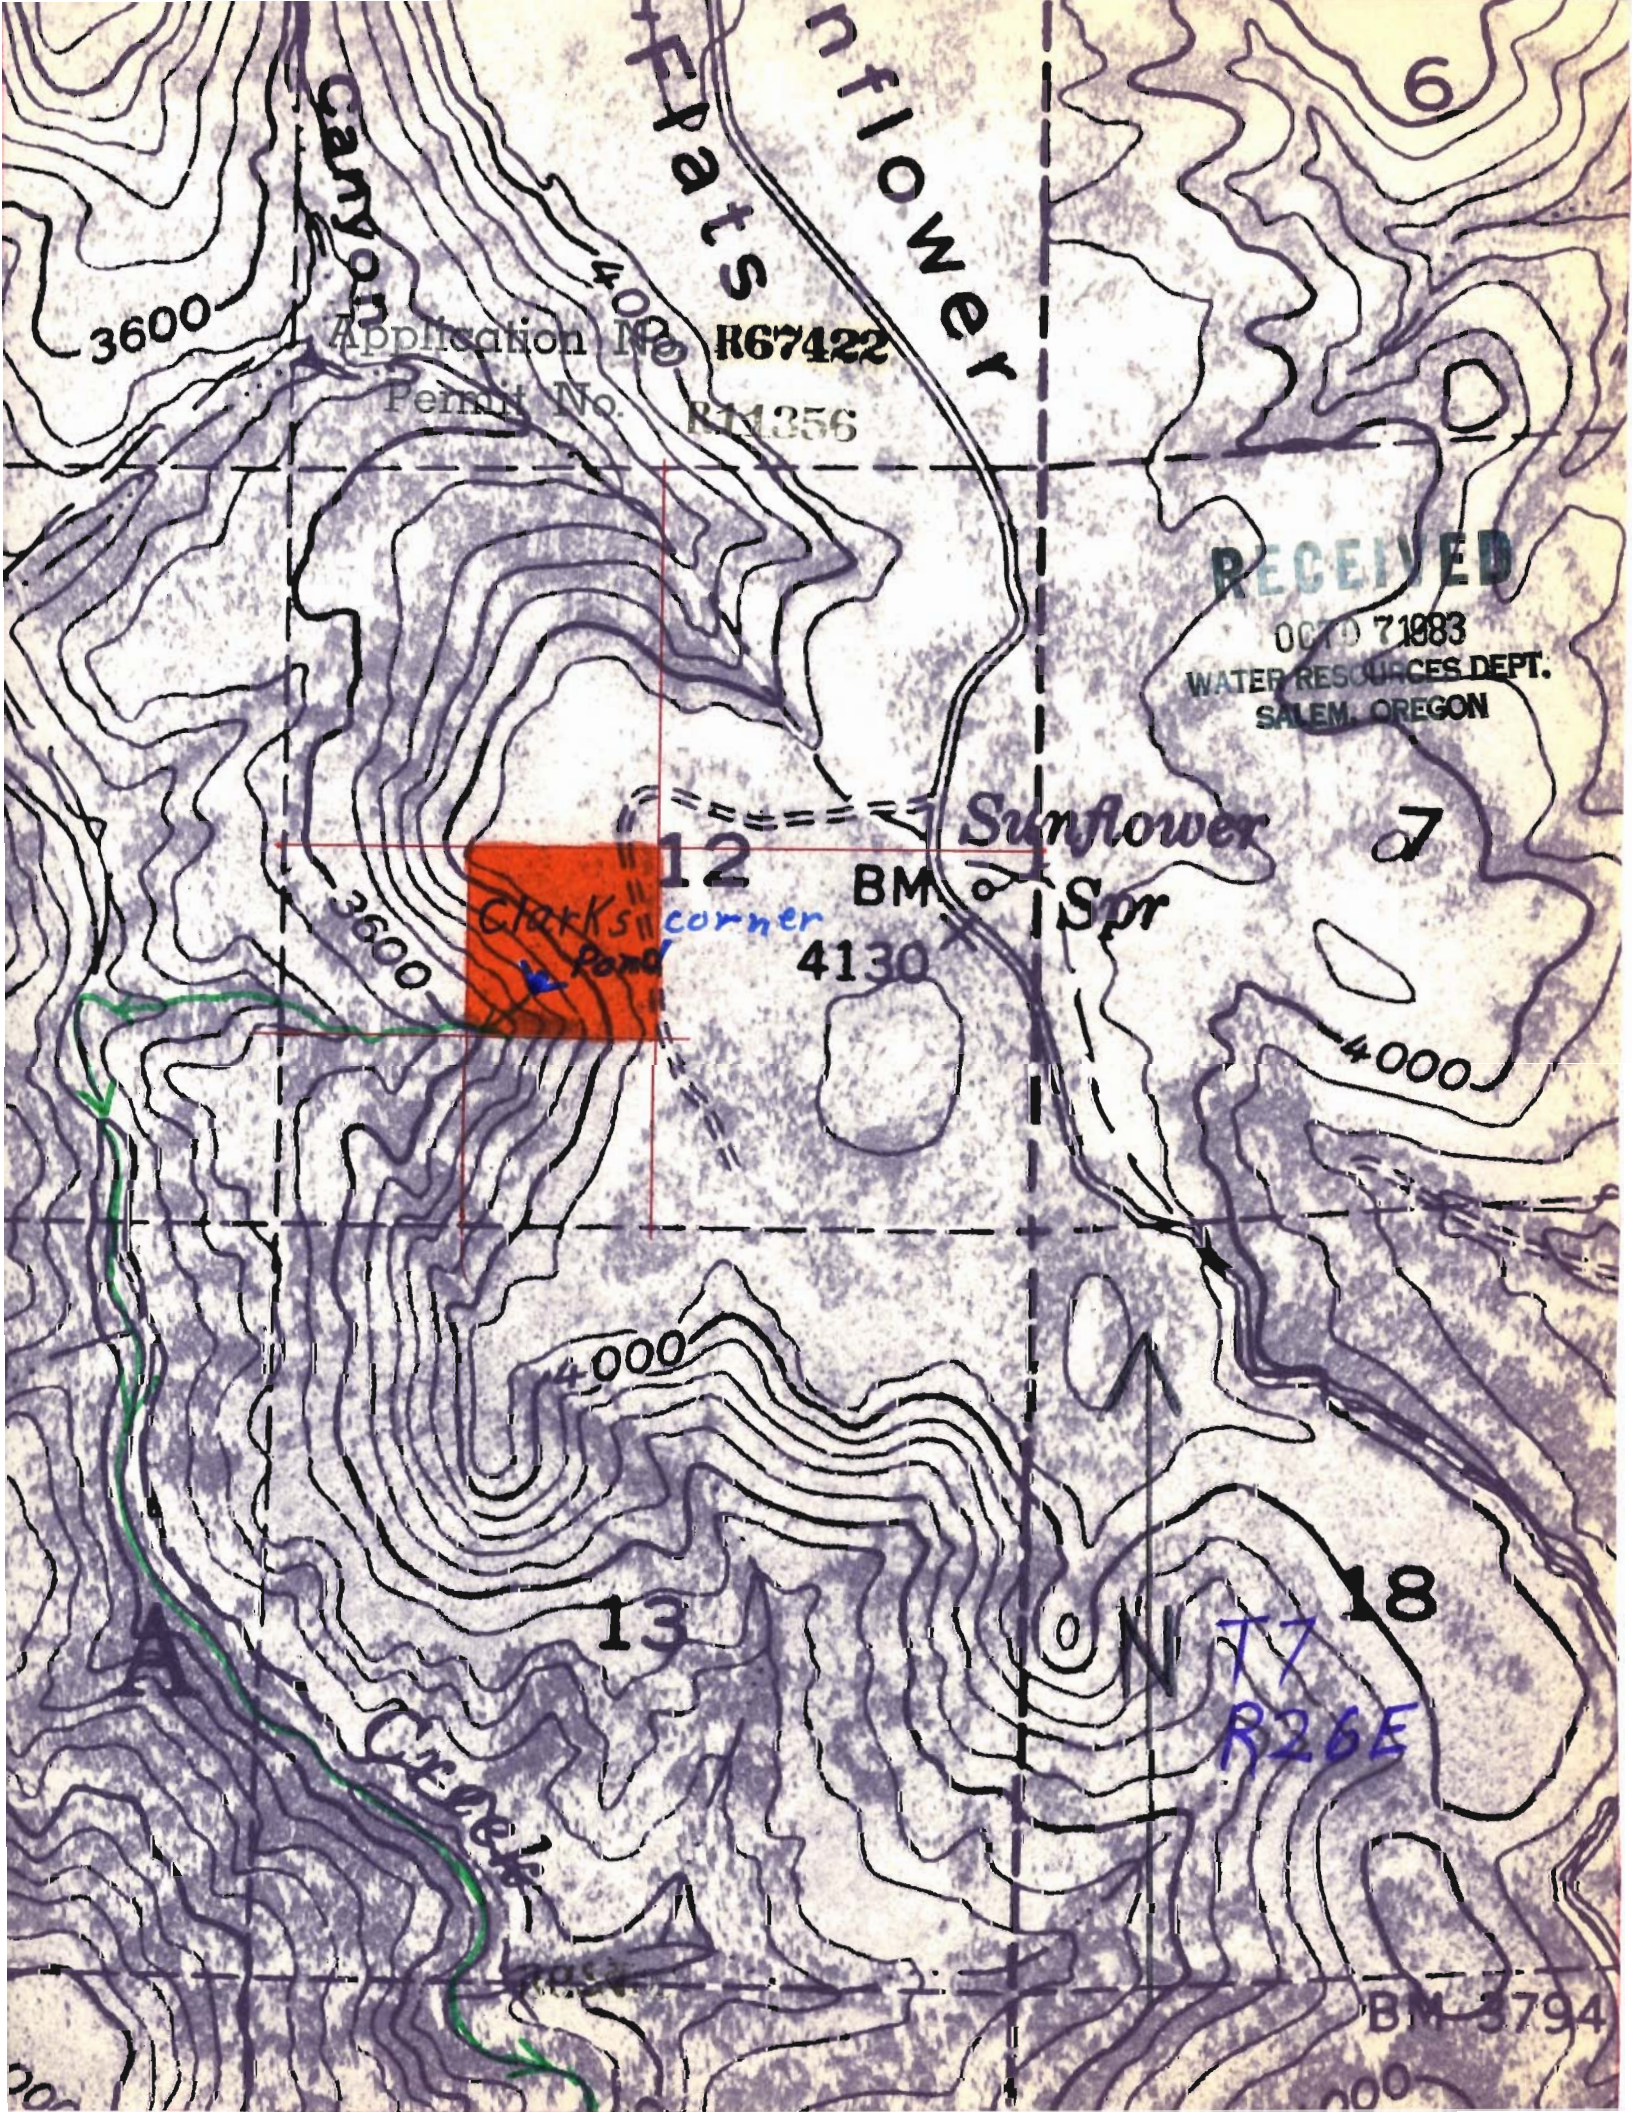

Canyon

Sunflower

3600

Application No. R67422
Permit No. R11356

RECEIVED

0070 71883
WATER RESOURCES DEPT.
SALEM, OREGON

3600

Clocks corner Pond

12

BM

4130

Sunflower Spr

4000

4000

13

Creek

N 77 R26E

BM 3794