

AMENDED MAP

to accompany application of

A.Y. MEYERS

for a permit to appropriate Water

Twp 25S., B. 13.W.W.M.

Sec 34.

Coos Co. Oregon

I, D.L. Buckingham of Marshfield Oregon, hereby certify that this map was made from notes taken during an actual survey made by me Aug 27, 1927 and that it correctly represents the works described in the accompanying application together with the location of the streams in the immediate vicinity


D.L. Buckingham



D.L. Buckingham


Application No. 9673

Permit No. 6379

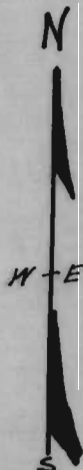

W-E

Scale  
one inch = 40 chains

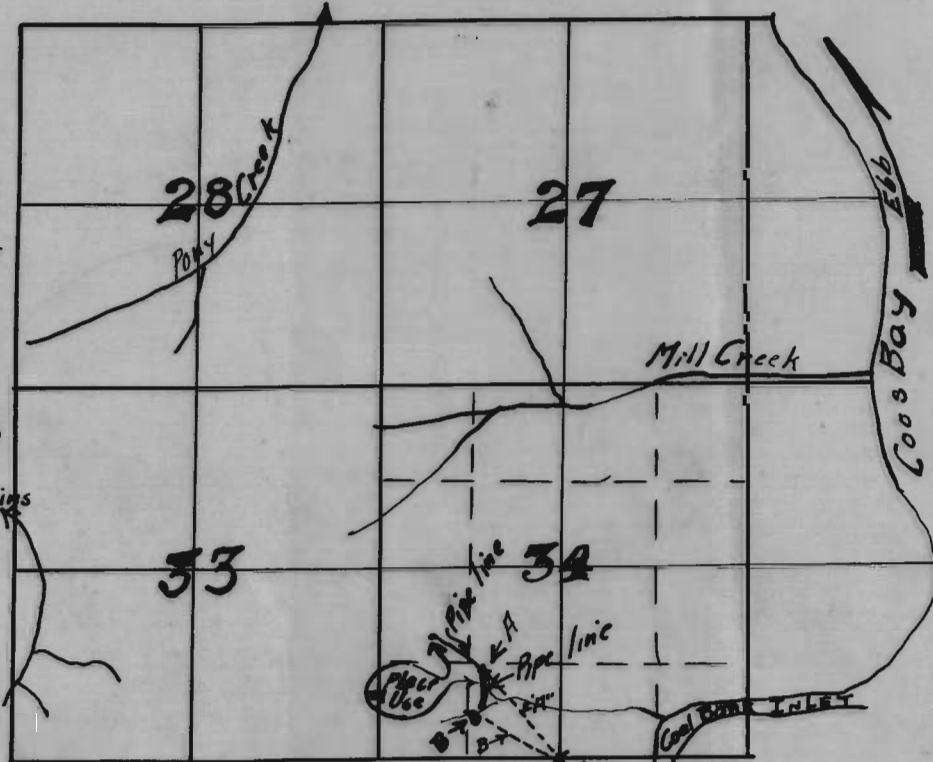

A-N 43° 57' W 148 1/4 Cor.  
B-N 68° 10' W 1327°