


T. 4 S. R. 3 W. W.M.

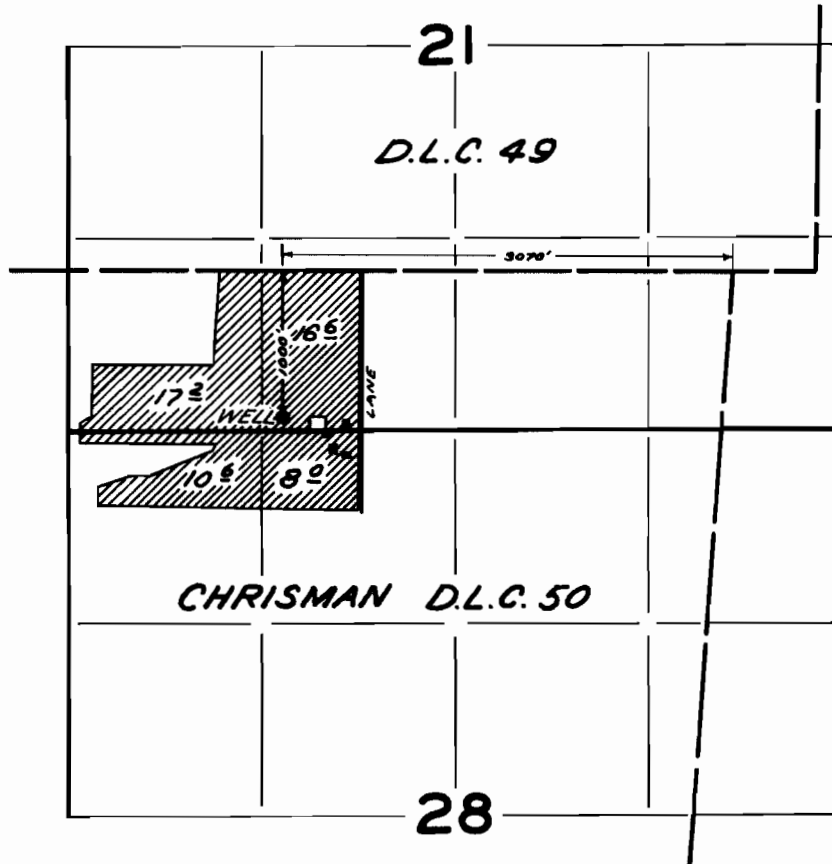

FINAL PROOF SURVEY
UNDER

Application No. G-2180 Permit No. G-2010
IN NAME OF

R. D. McCulloch

Surveyed MAY 5 1967, by V. GARNER