

Form A1-187
March 1961

UNITED STATES
DEPARTMENT OF THE INTERIOR
BUREAU OF LAND MANAGEMENT

SECTION


12

Oregon State Water Filings

SE $\frac{1}{4}$ NW $\frac{1}{4}$

TOWNSHIP 38 S, RANGE 26 E, W. M.

Tied in with aerial photos & O.S.H.D. Quad Maps

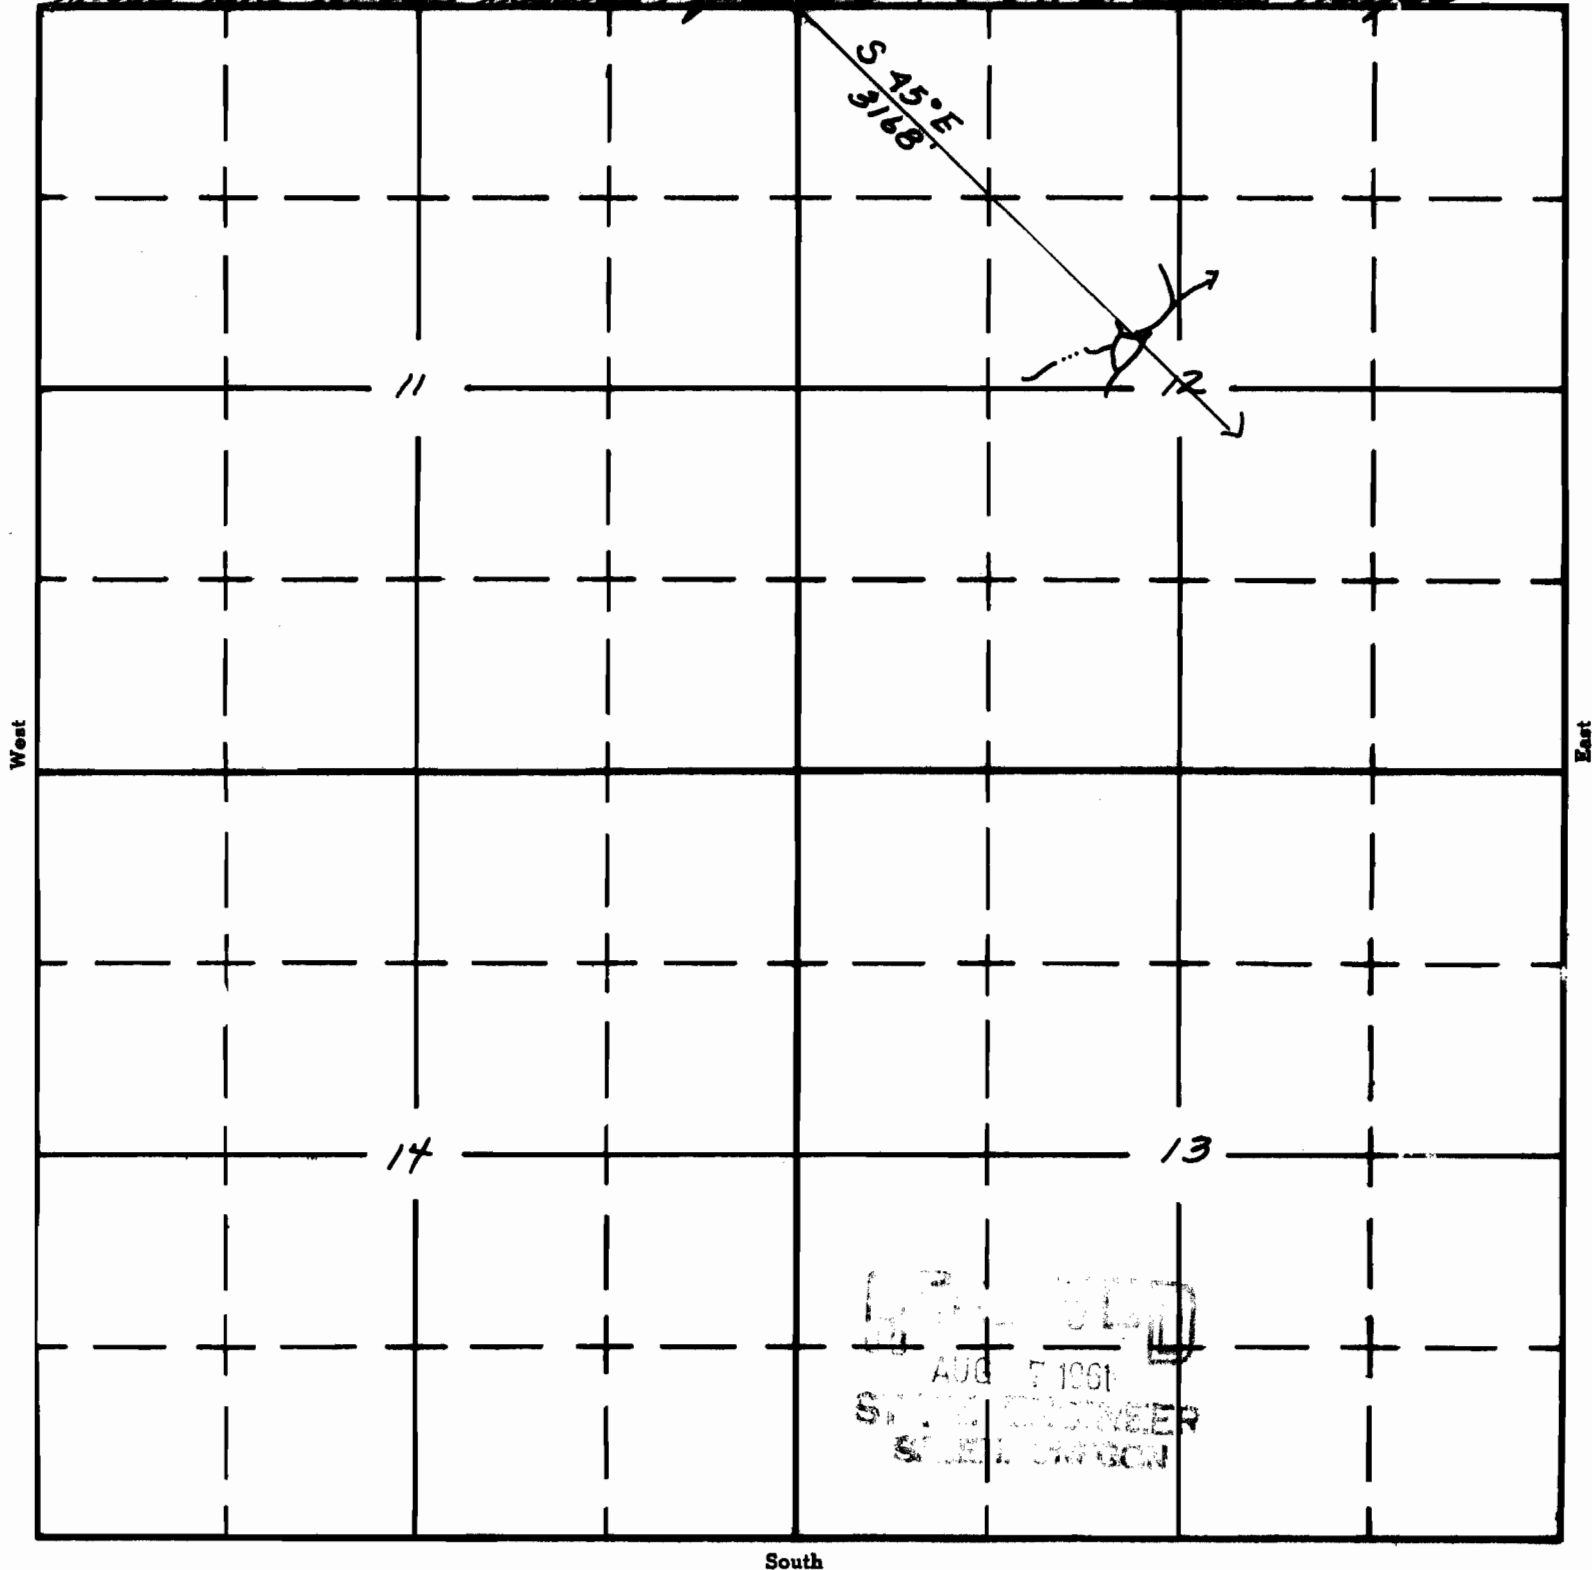

South

APPLICATION No. R-36233

PERMIT No. R-4082