

UNITED STATES
DEPARTMENT OF THE INTERIOR
BUREAU OF LAND MANAGEMENT

SECTION


5

Oregon State Water Filings

N 1/2 NE 1/4

TOWNSHIP 30S, RANGE 29E, W. M.

Tied in with aerial photo in O.S.H.D. Quad Maps

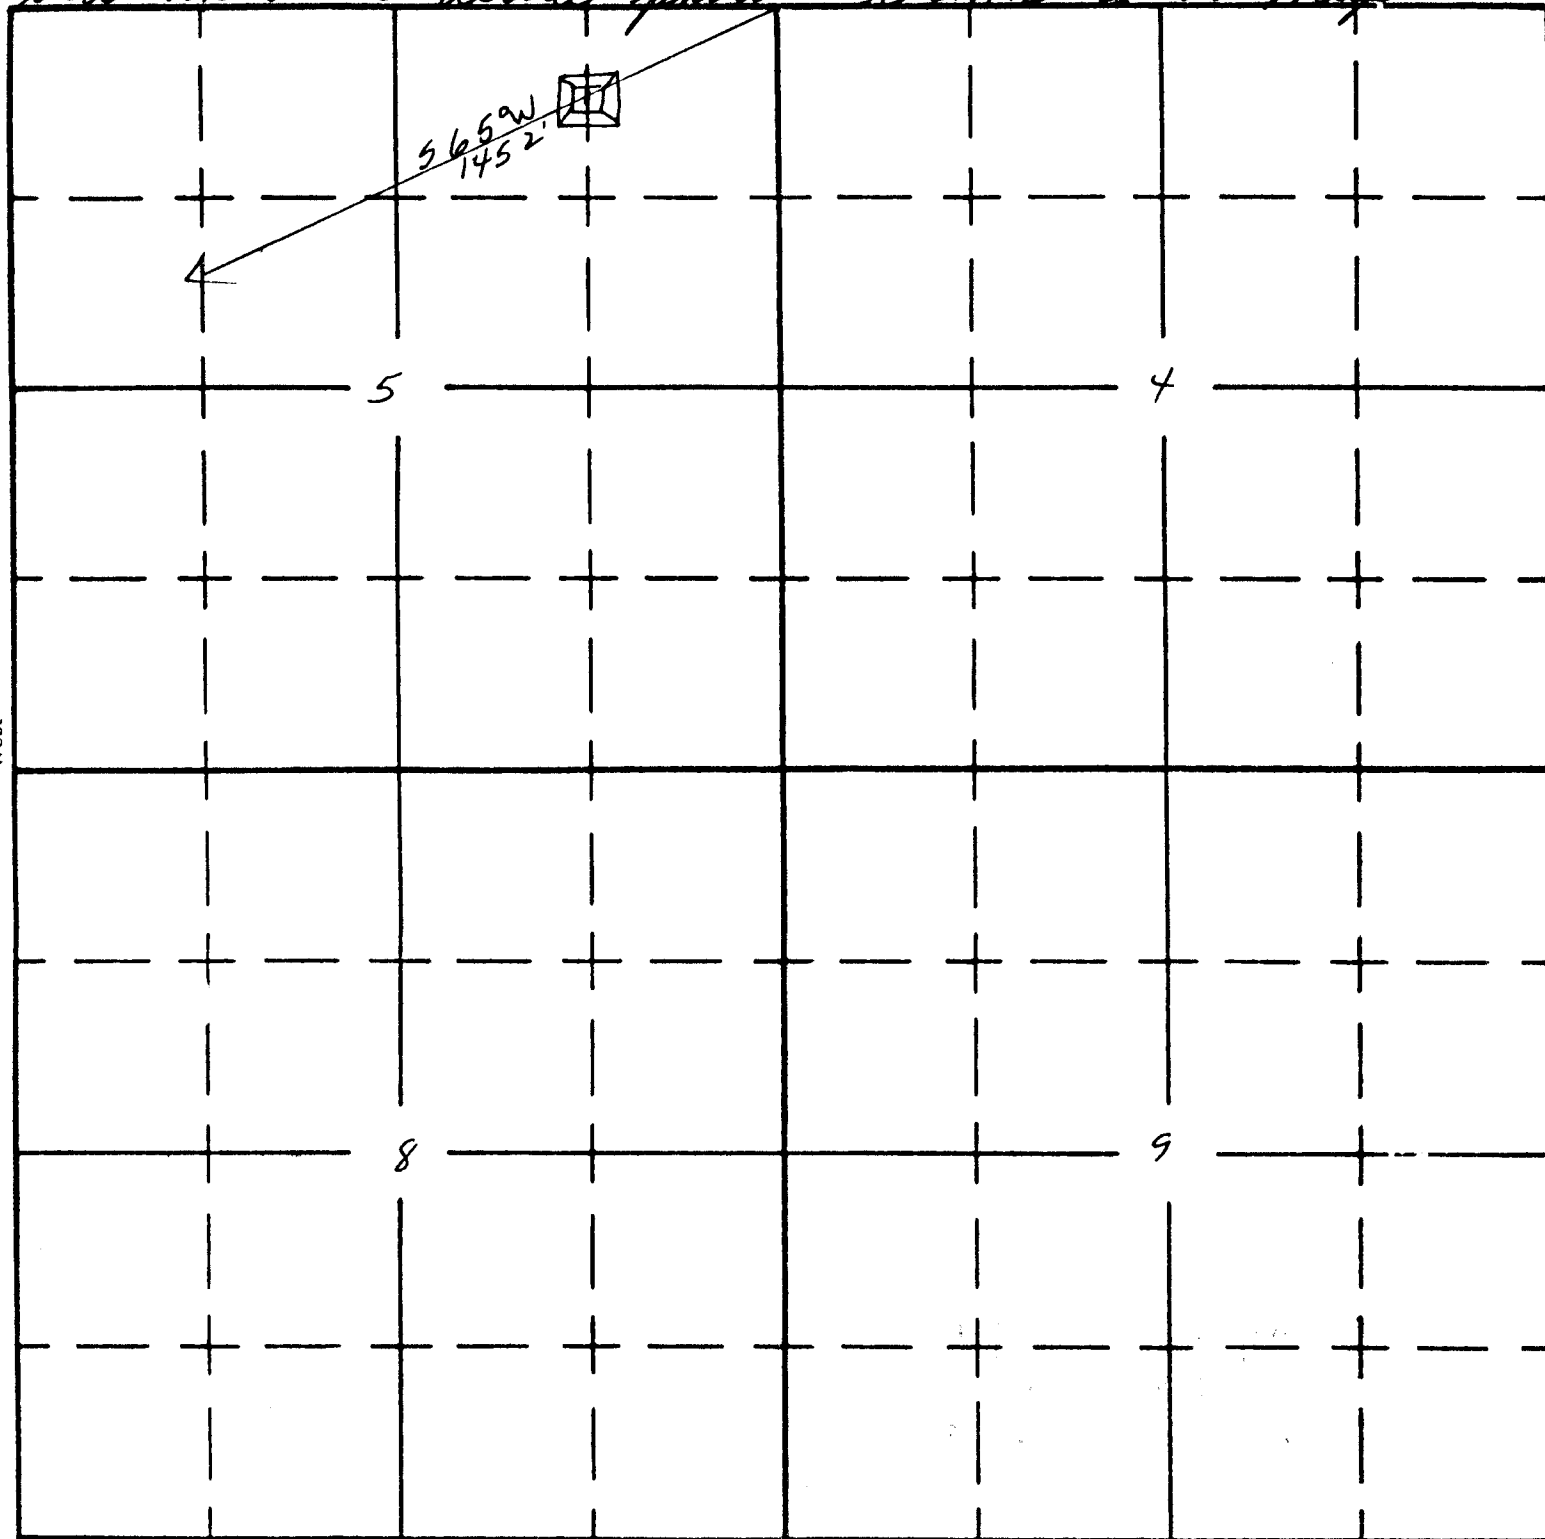

South

APPLICATION No. R-36814

RECEIVED BY R-4096