

UNITED STATES  
DEPARTMENT OF THE INTERIOR  
BUREAU OF LAND MANAGEMENT


SECTION 12

Oregon State Water Filings

NE & NW 1/4

TOWNSHIP 40S, RANGE 30E, W. M.

TIED-IN WITH AERIAL PHOTOS AND <sup>North</sup> U.S.N.D. QUAD MAPS

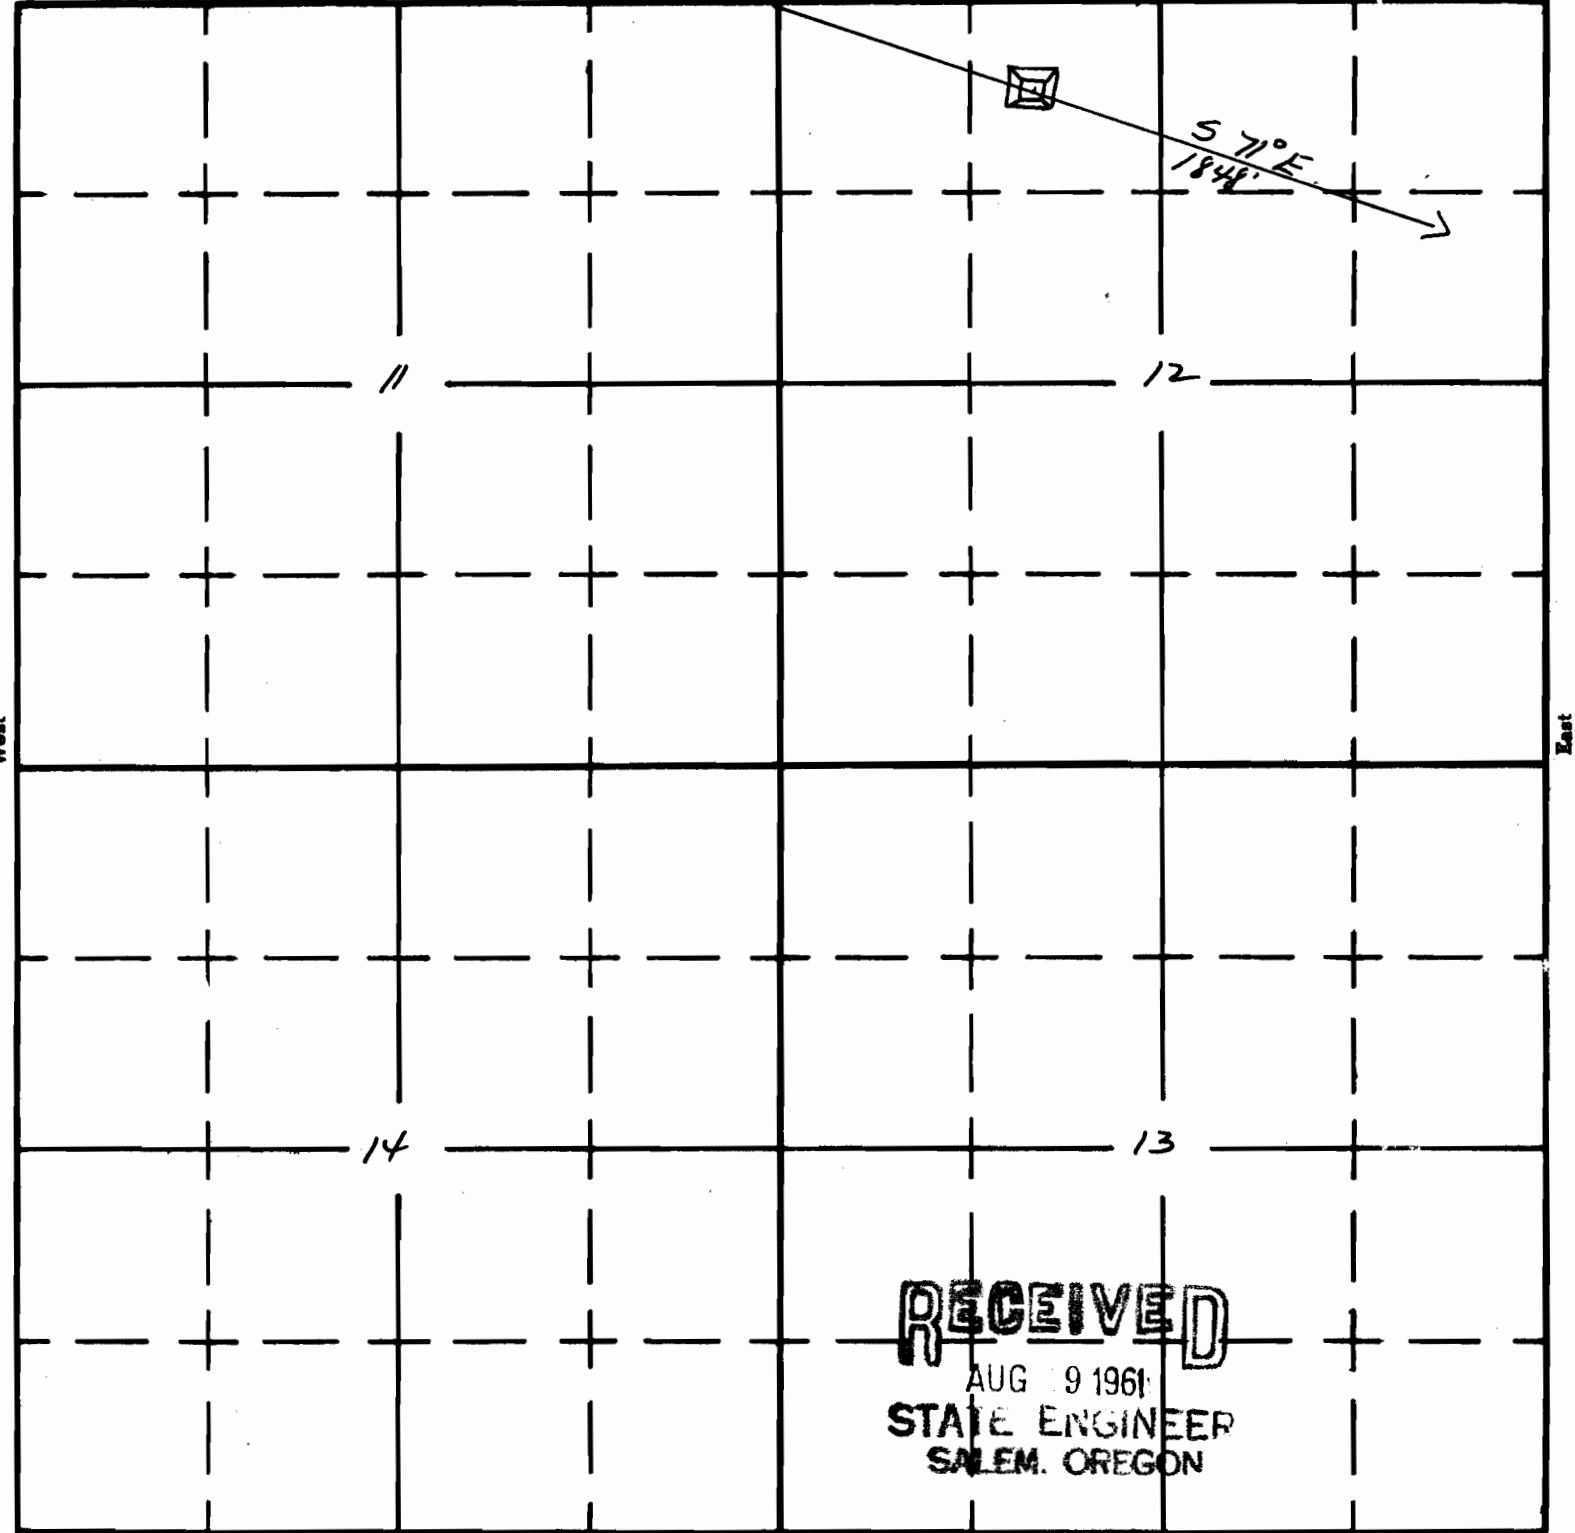

RECEIVED  
AUG 19 1961  
STATE ENGINEER  
SALEM, OREGON