

UNITED STATES
DEPARTMENT OF THE INTERIOR
BUREAU OF LAND MANAGEMENT

SECTION


8

NW 1/4 SW 1/4

Oregon State Water Filings

TOWNSHIP 39S, RANGE 26E, W. M.

North

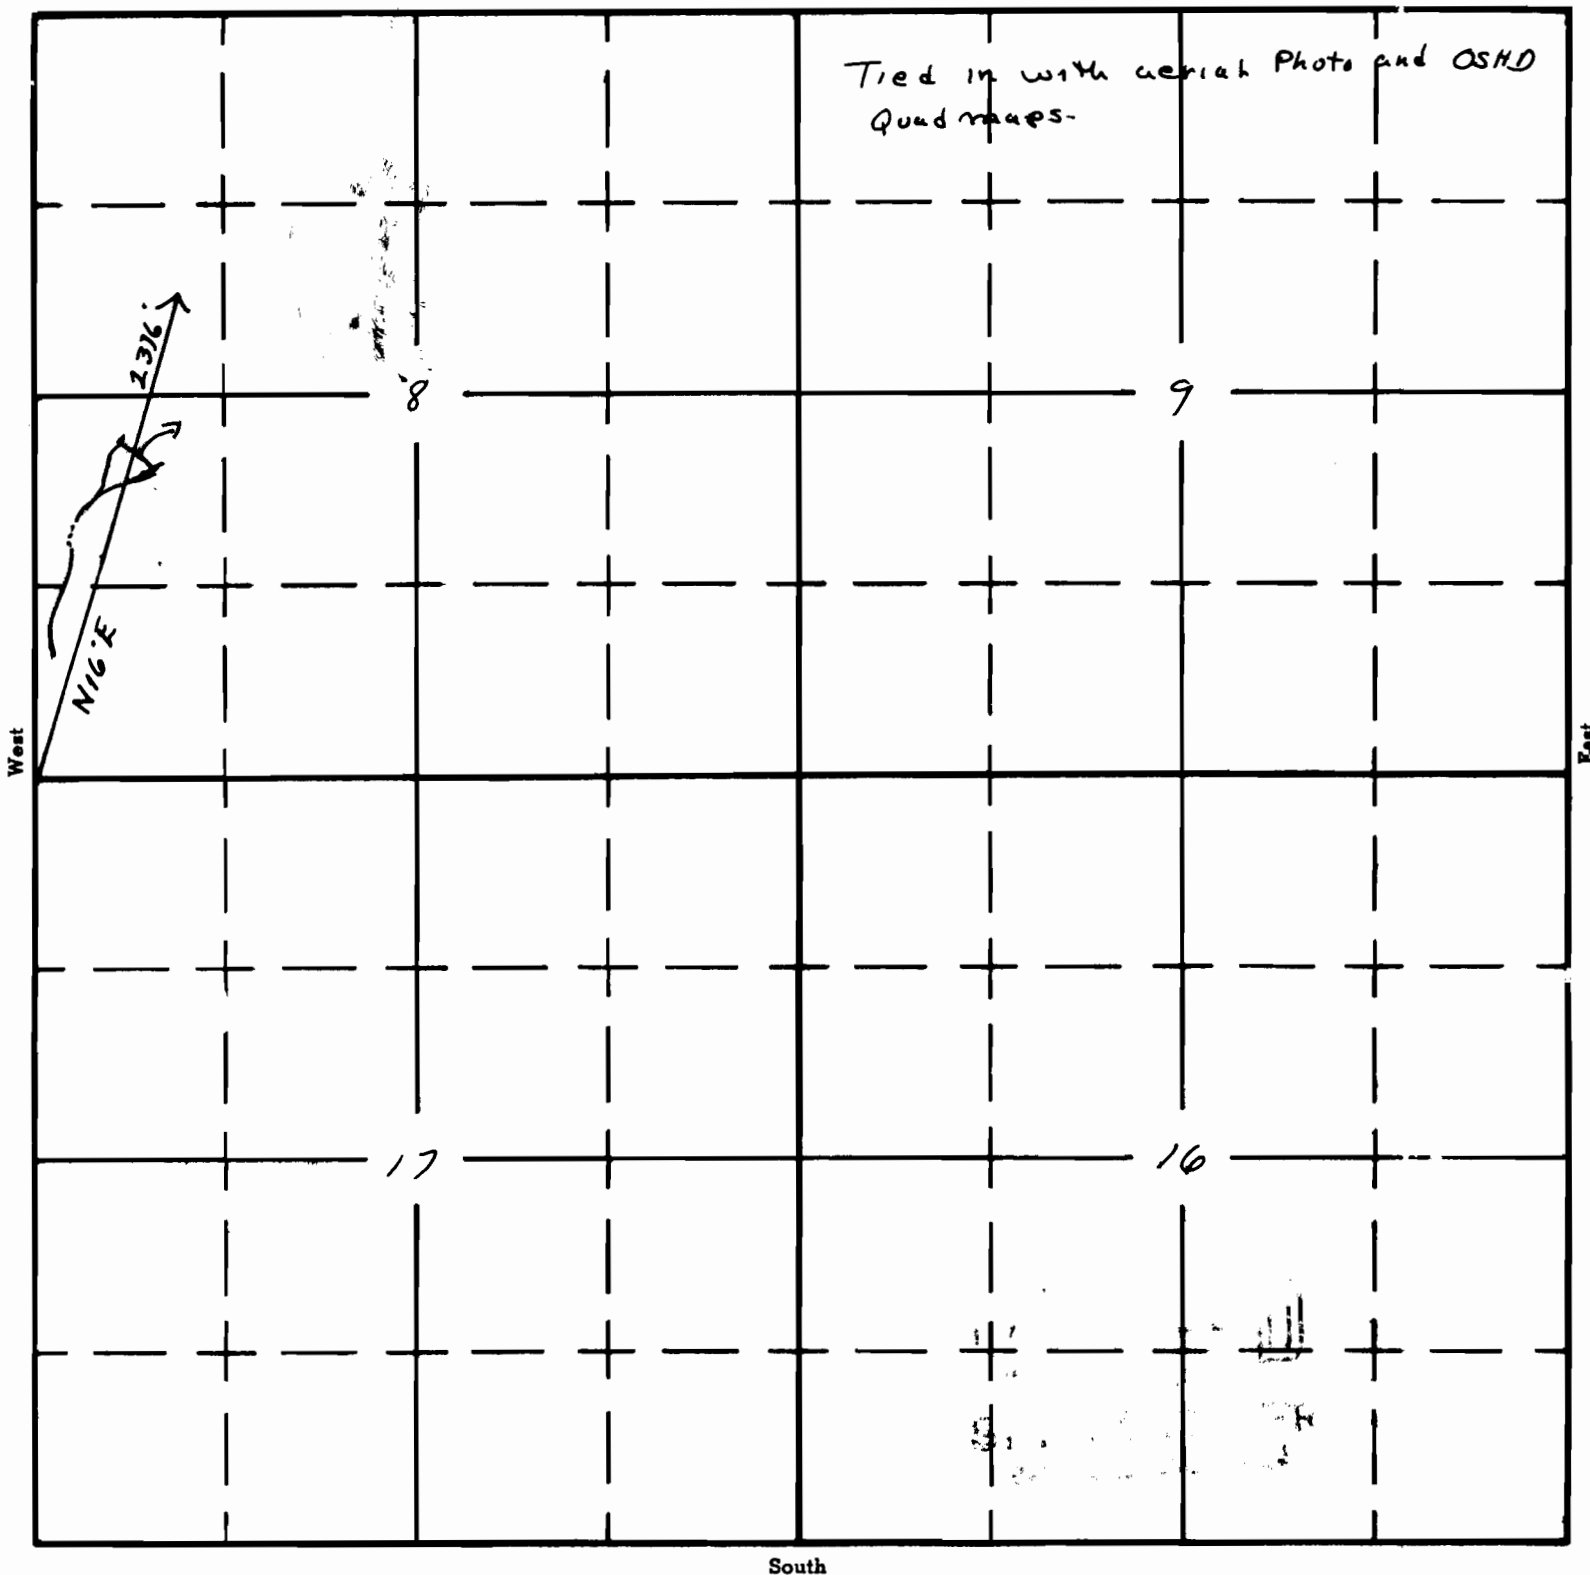

South

APPLICATION No. R-35812
PERMIT No. R-4203