Form A1-187
March 1961


UNITED STATES
DEPARTMENT OF THE INTERIOR
BUREAU OF LAND MANAGEMENT

SECTION 34
SE¼ SW¼

Oregon State Water Filings

TOWNSHIP 38S, RANGE 27E, W. M.

North Tied in with aerial Photo and OSED Quad Maps.

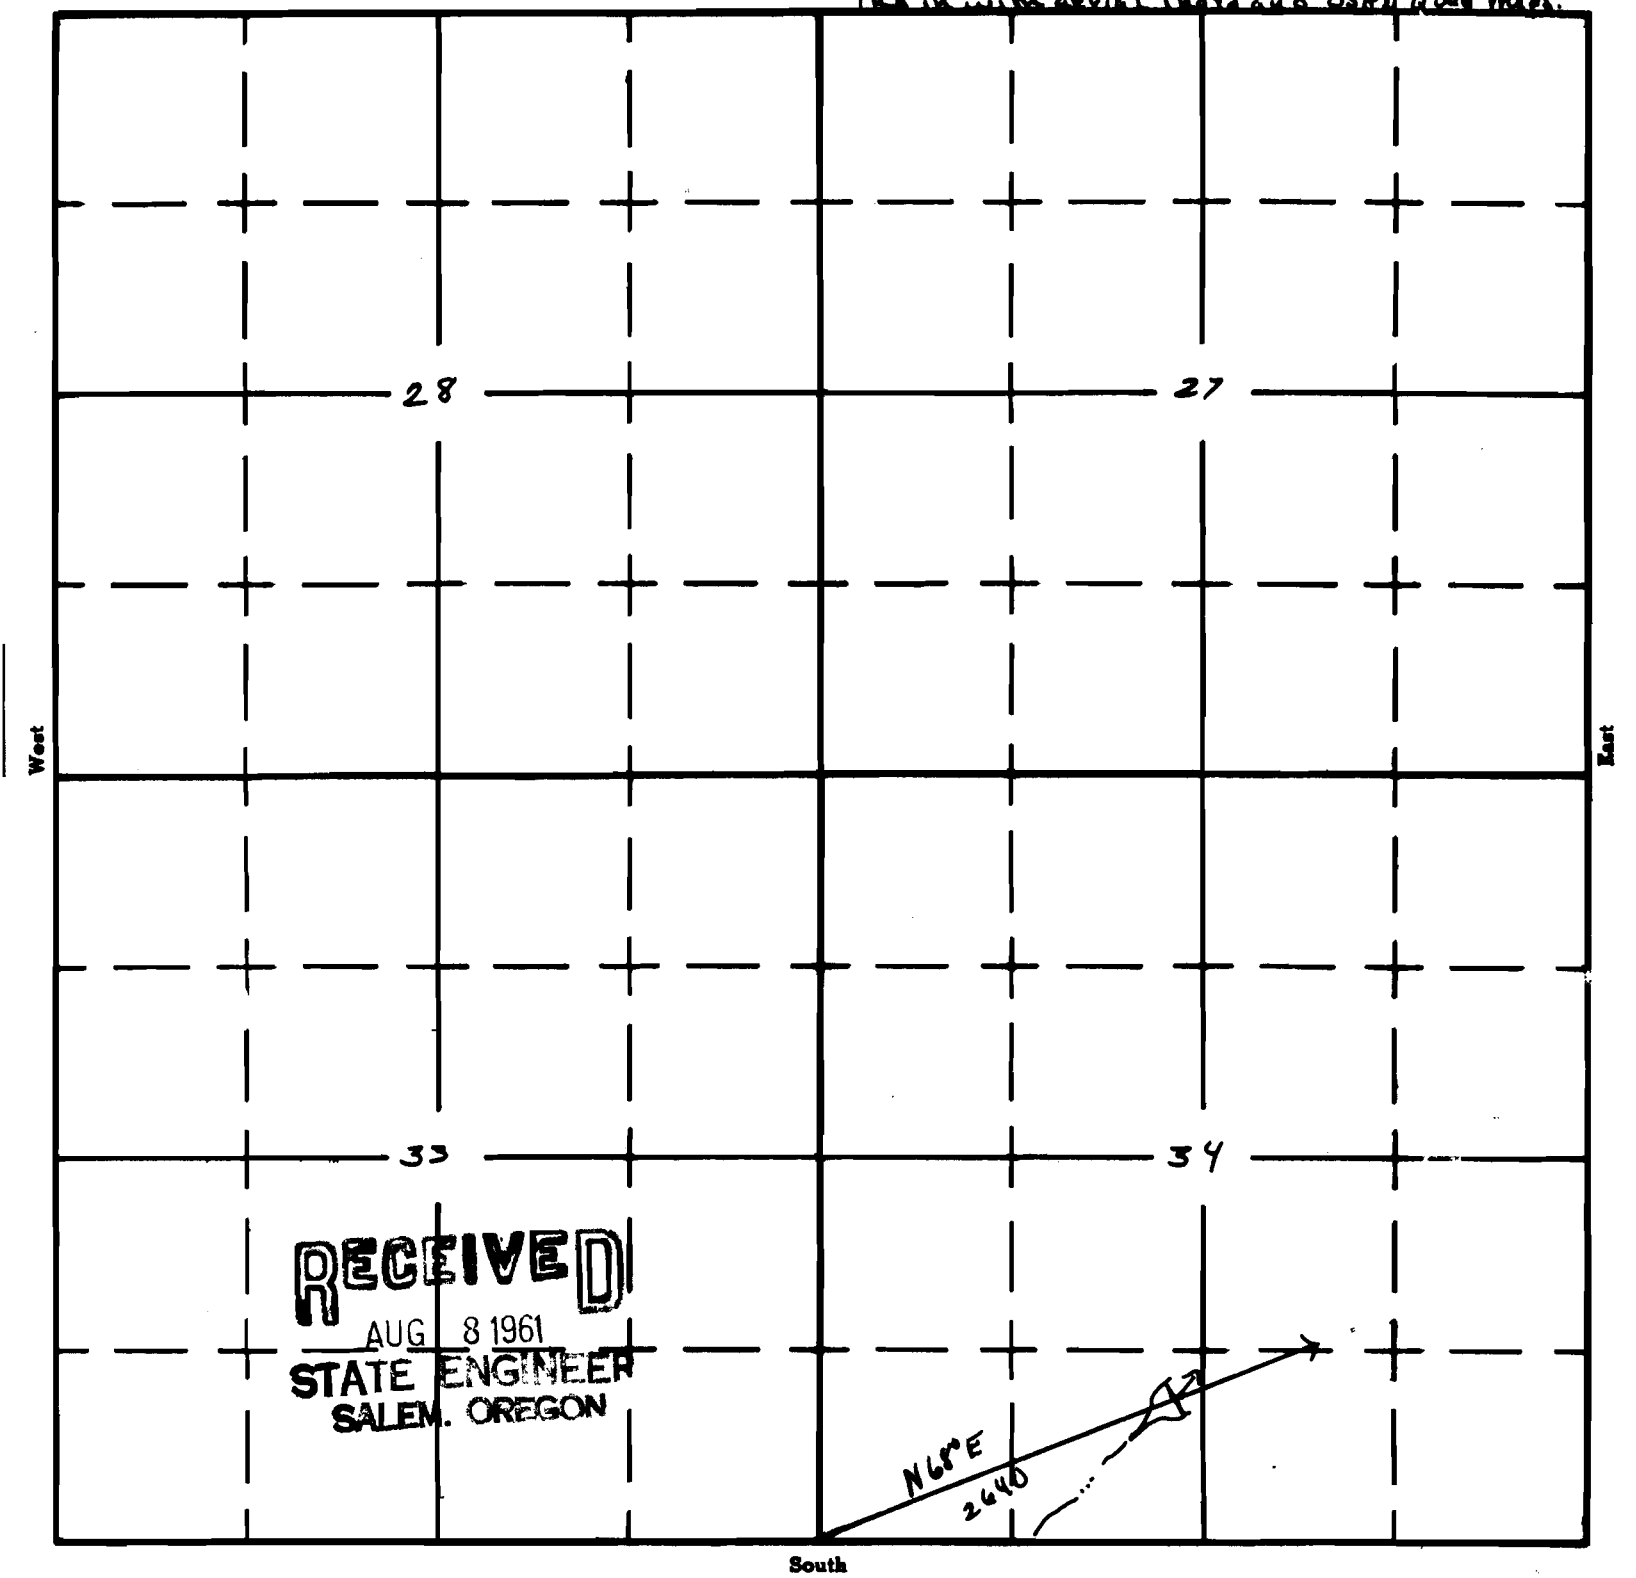

RECEIVED
AUG 8 1961
STATE ENGINEER
SALEM, OREGON

APPLICATION No. R-36341
PERMIT No. R-4223