

Form AI-187
March 1961

UNITED STATES
DEPARTMENT OF THE INTERIOR
BUREAU OF LAND MANAGEMENT

SECTION


12

Oregon State Water Filings

SW 1/4 NW 1/4

TOWNSHIP 37 S, RANGE 29 E, W. M.

Filed in with aerial photos & O.S.L.D. Quad Maps

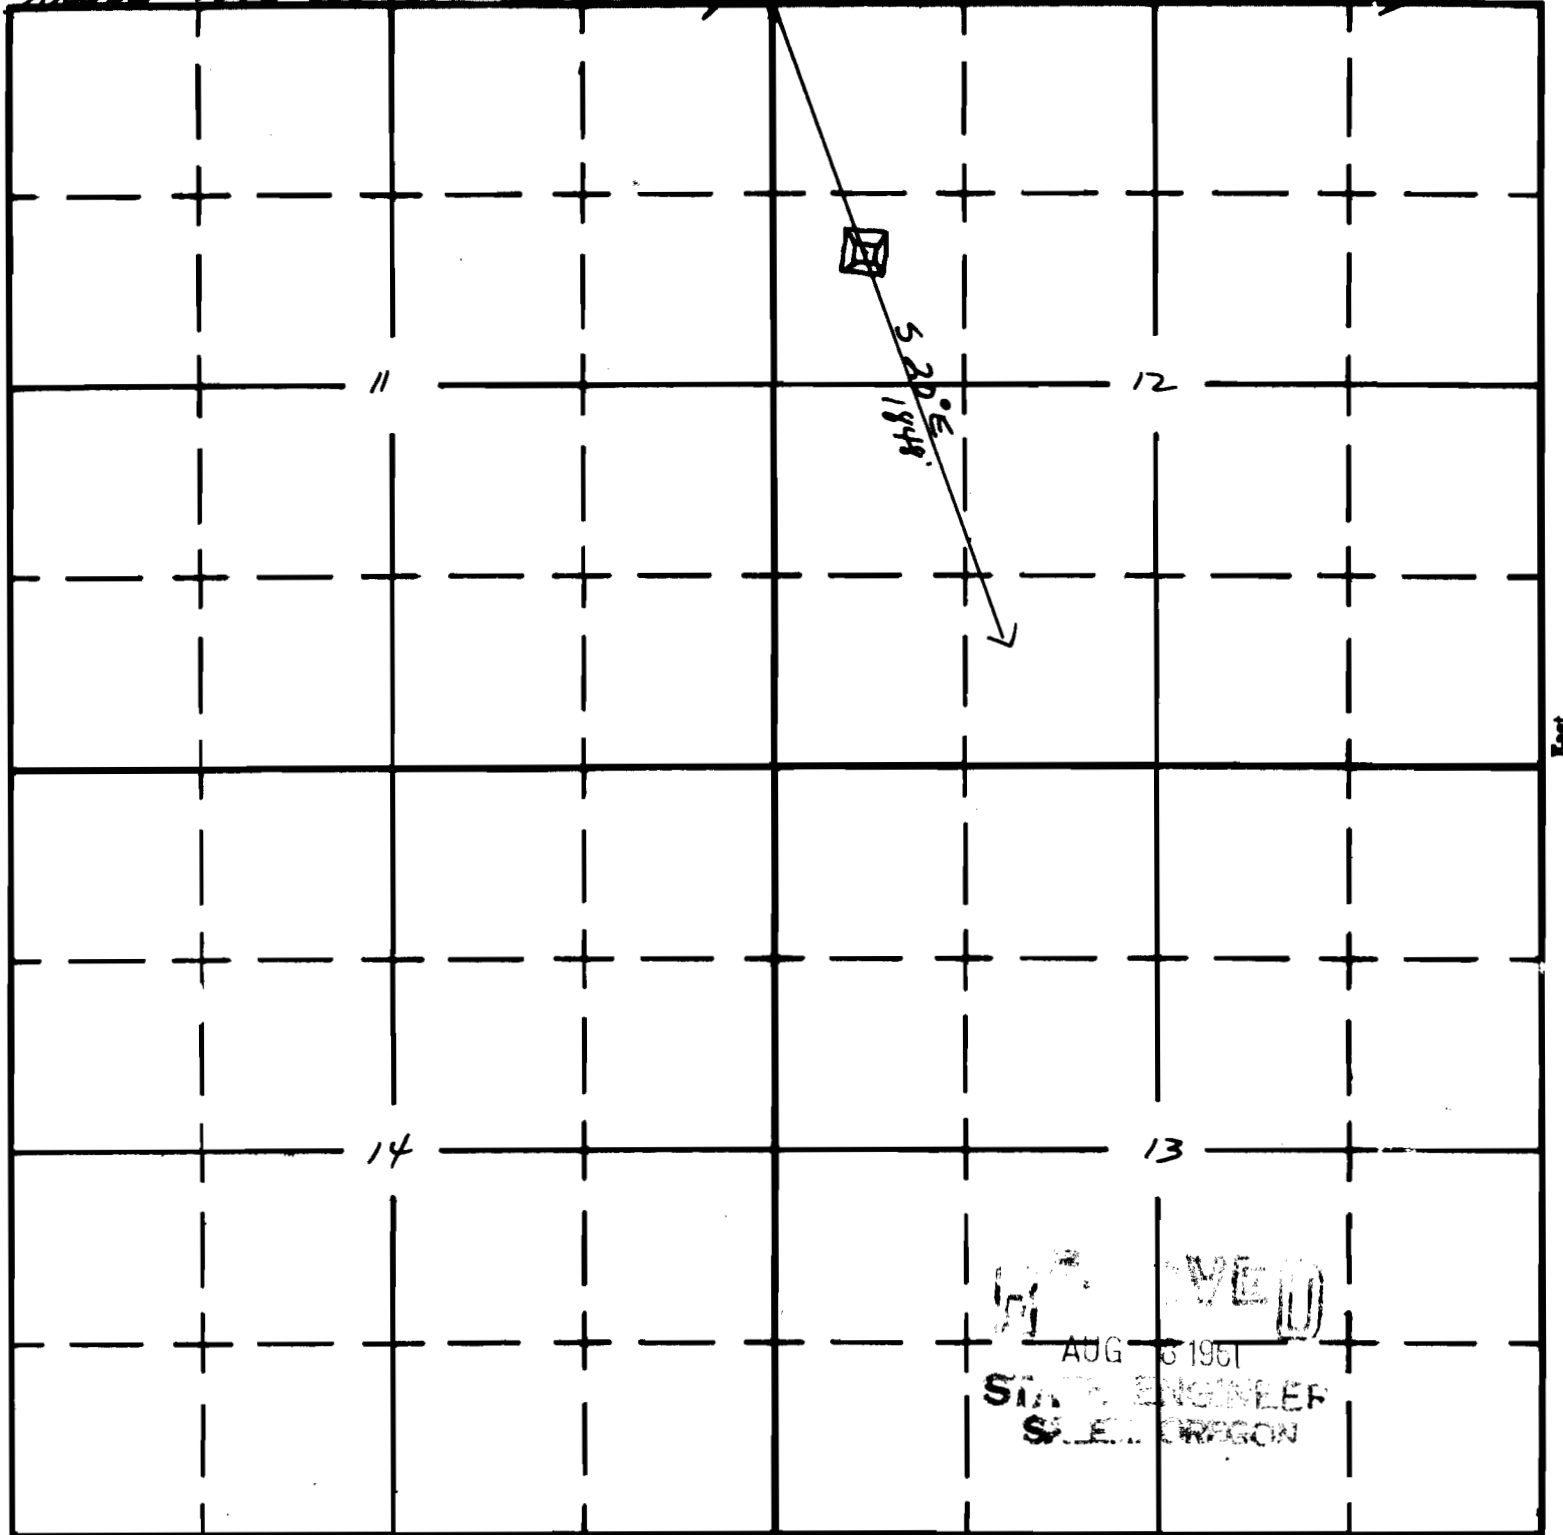

RECEIVED
AUG 3 1961
STATE ENGINEER
STATE OF OREGON

South

APPLICATION No. **R-36384**

PERMIT No. **R-4229**