


T. 24. SR. 8 E. WM. R. 9. E. WM.

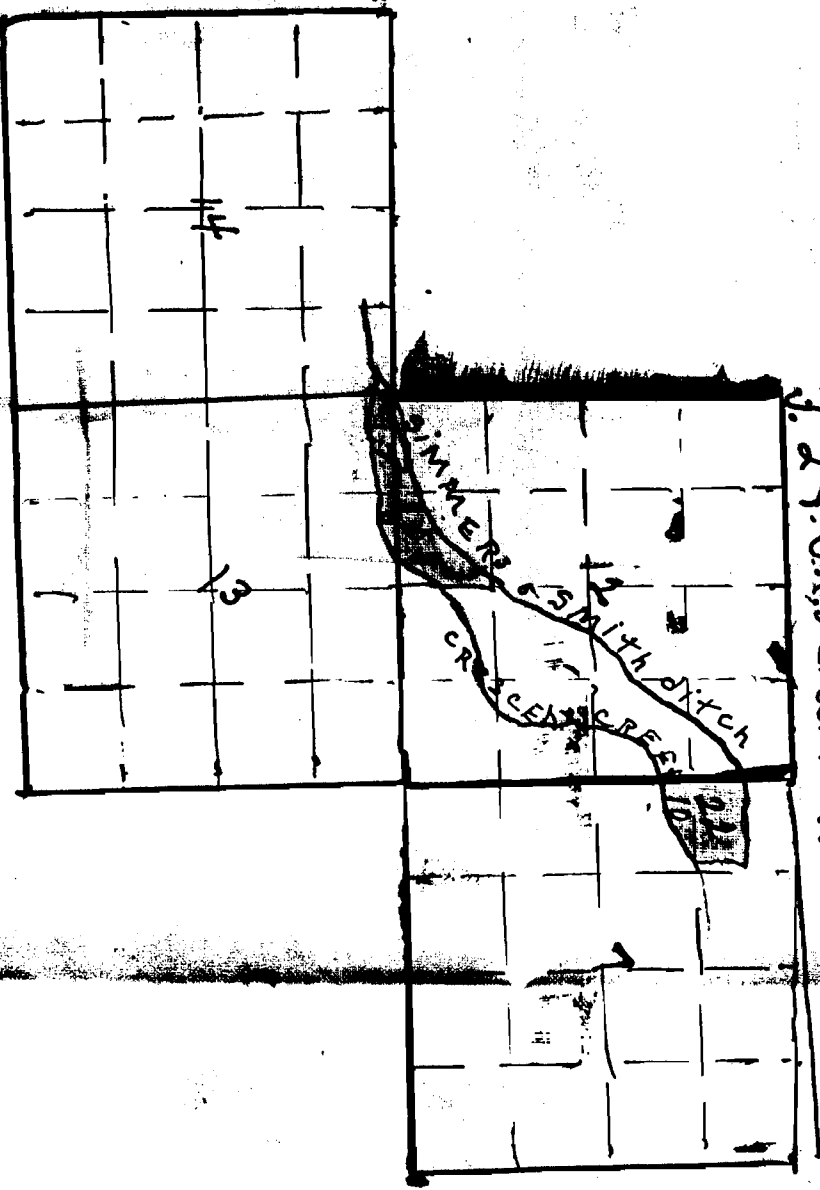

Application No. 9868

9868