

Form A1-187
March 1961

UNITED STATES
DEPARTMENT OF THE INTERIOR
BUREAU OF LAND MANAGEMENT


SECTION 11

Oregon State Water Filings

SW¹/₄ SW¹/₄

TOWNSHIP 40S, RANGE 29E, W. M.

TIED-IN WITH AERIAL PHOTOS AND U.S.G.S. QUAD MAPS.

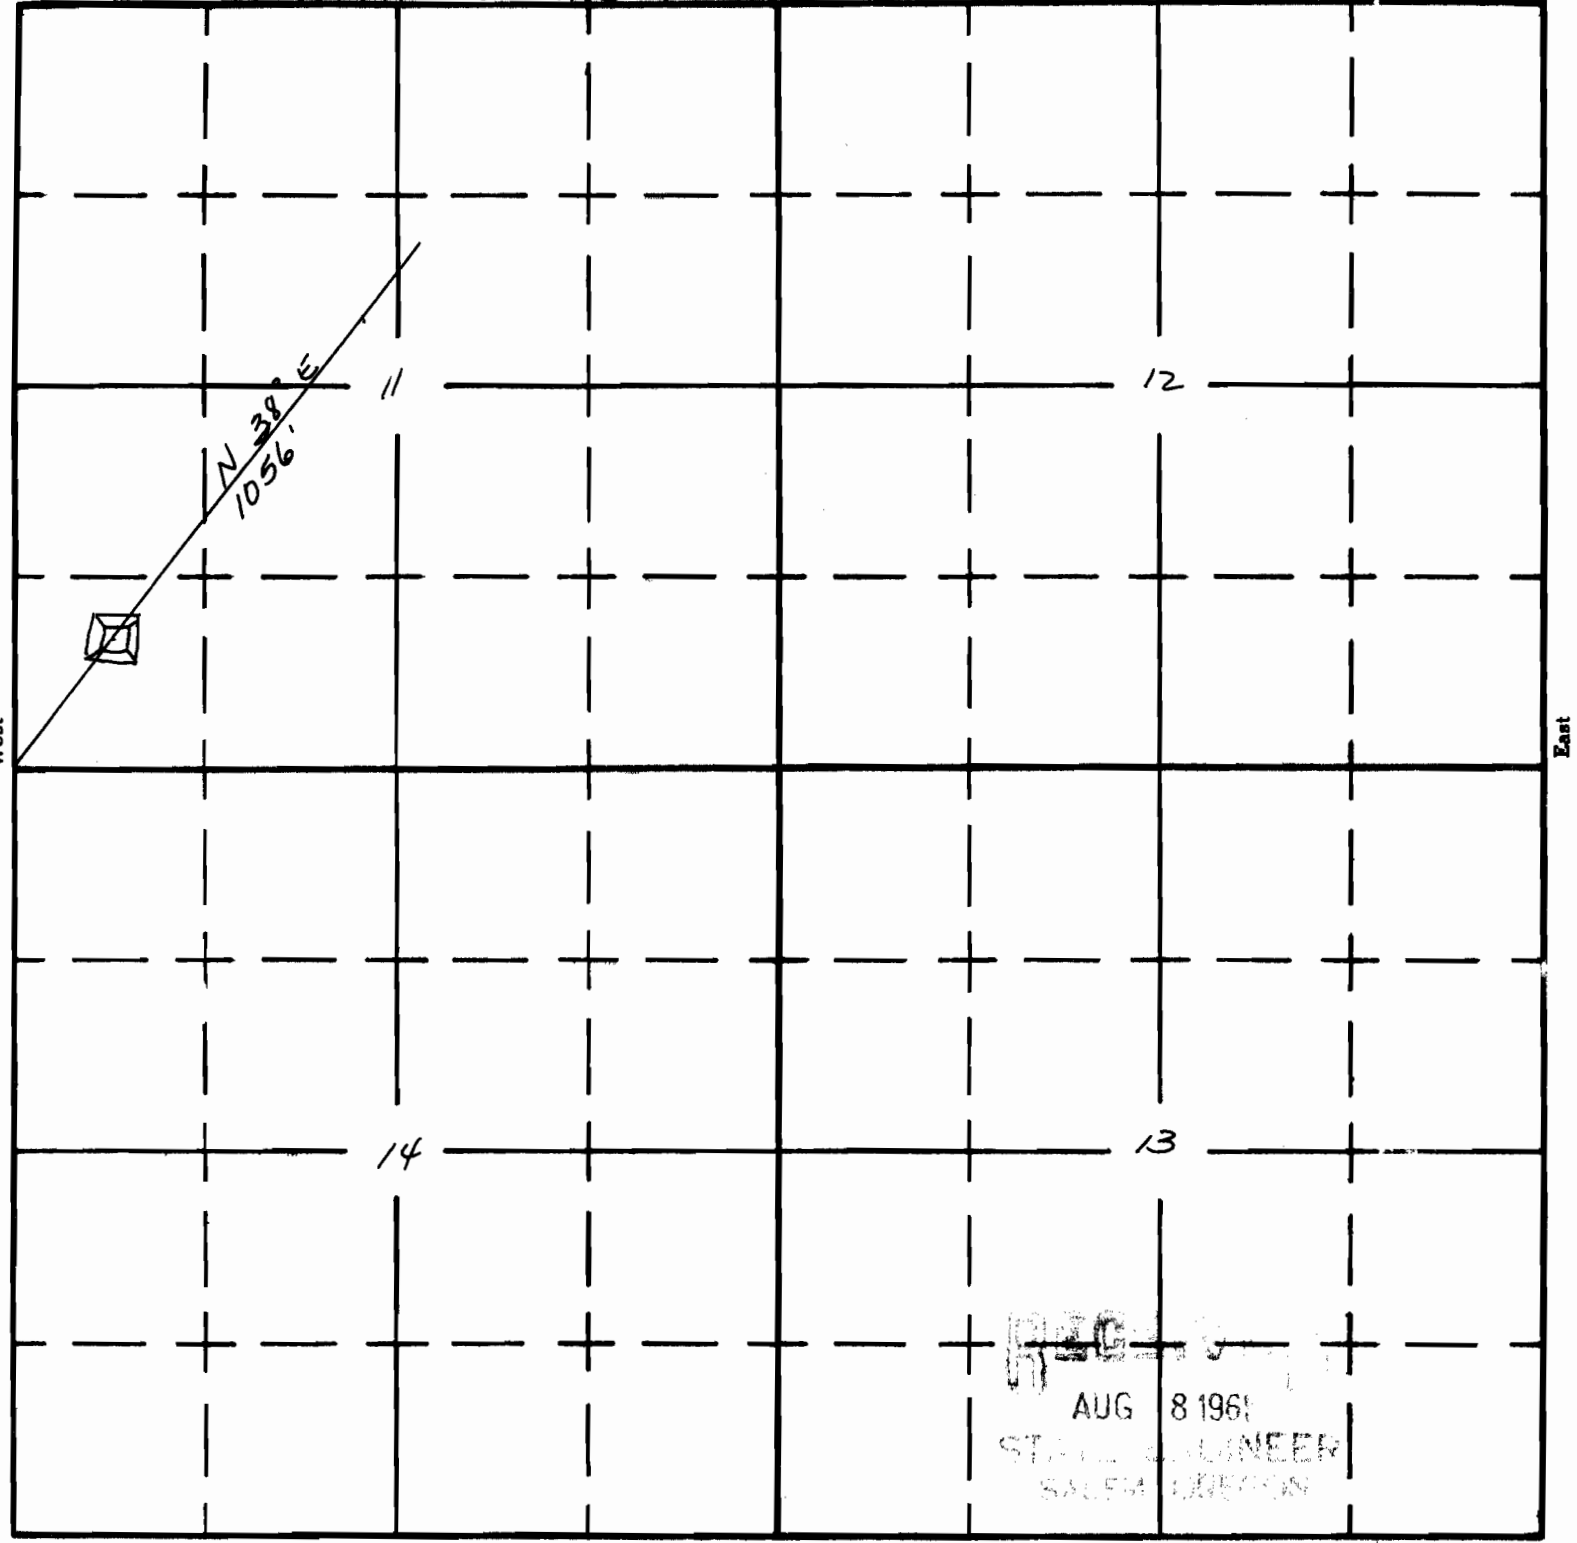

RECEIVED
AUG 8 1961
STATE ENGINEER
SALEM, OREGON

APPLICATION No. **R-36519**
PERMIT No. **R-4239**