

Form A1-187
March 1961

UNITED STATES
DEPARTMENT OF THE INTERIOR
BUREAU OF LAND MANAGEMENT

SECTION


4

Oregon State Water Filings

NE 1/4 NE 1/4

TOWNSHIP 41 S, RANGE 29 E, W. M.

TIED IN WITH AERIAL PHOTOS AND Q.S.H.D. QUAD MAPS

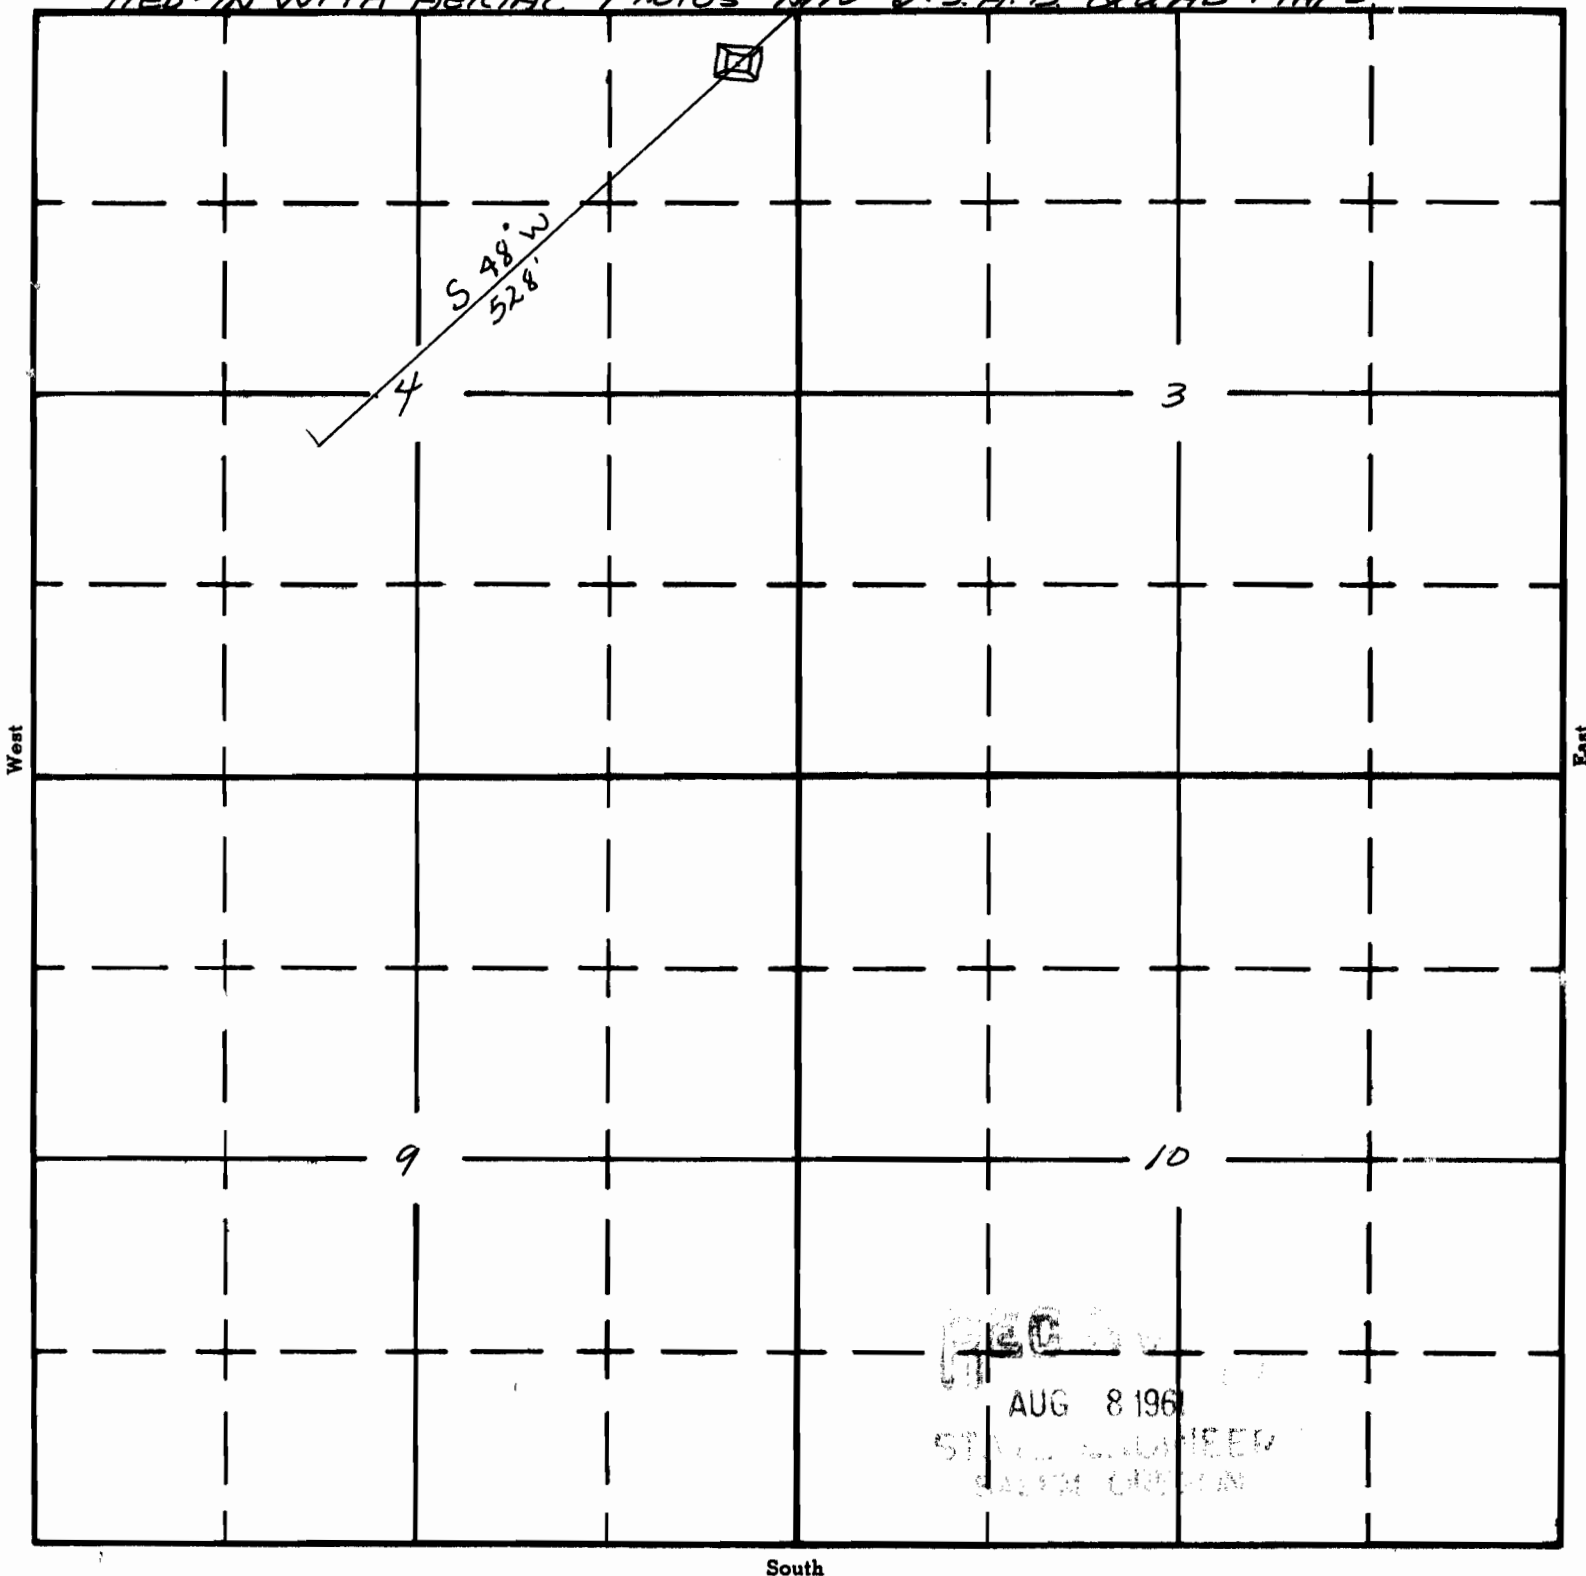

APPLICATION No. R-36521
PERMIT No. R-4241