

UNITED STATES
DEPARTMENT OF THE INTERIOR
BUREAU OF LAND MANAGEMENT

SECTION


10

SW 1/4 NW 1/4

Oregon State Water Filings

TOWNSHIP 39S, RANGE 29E, W. M.

North Tied in with aerial Photo and GND Aerial Maps.

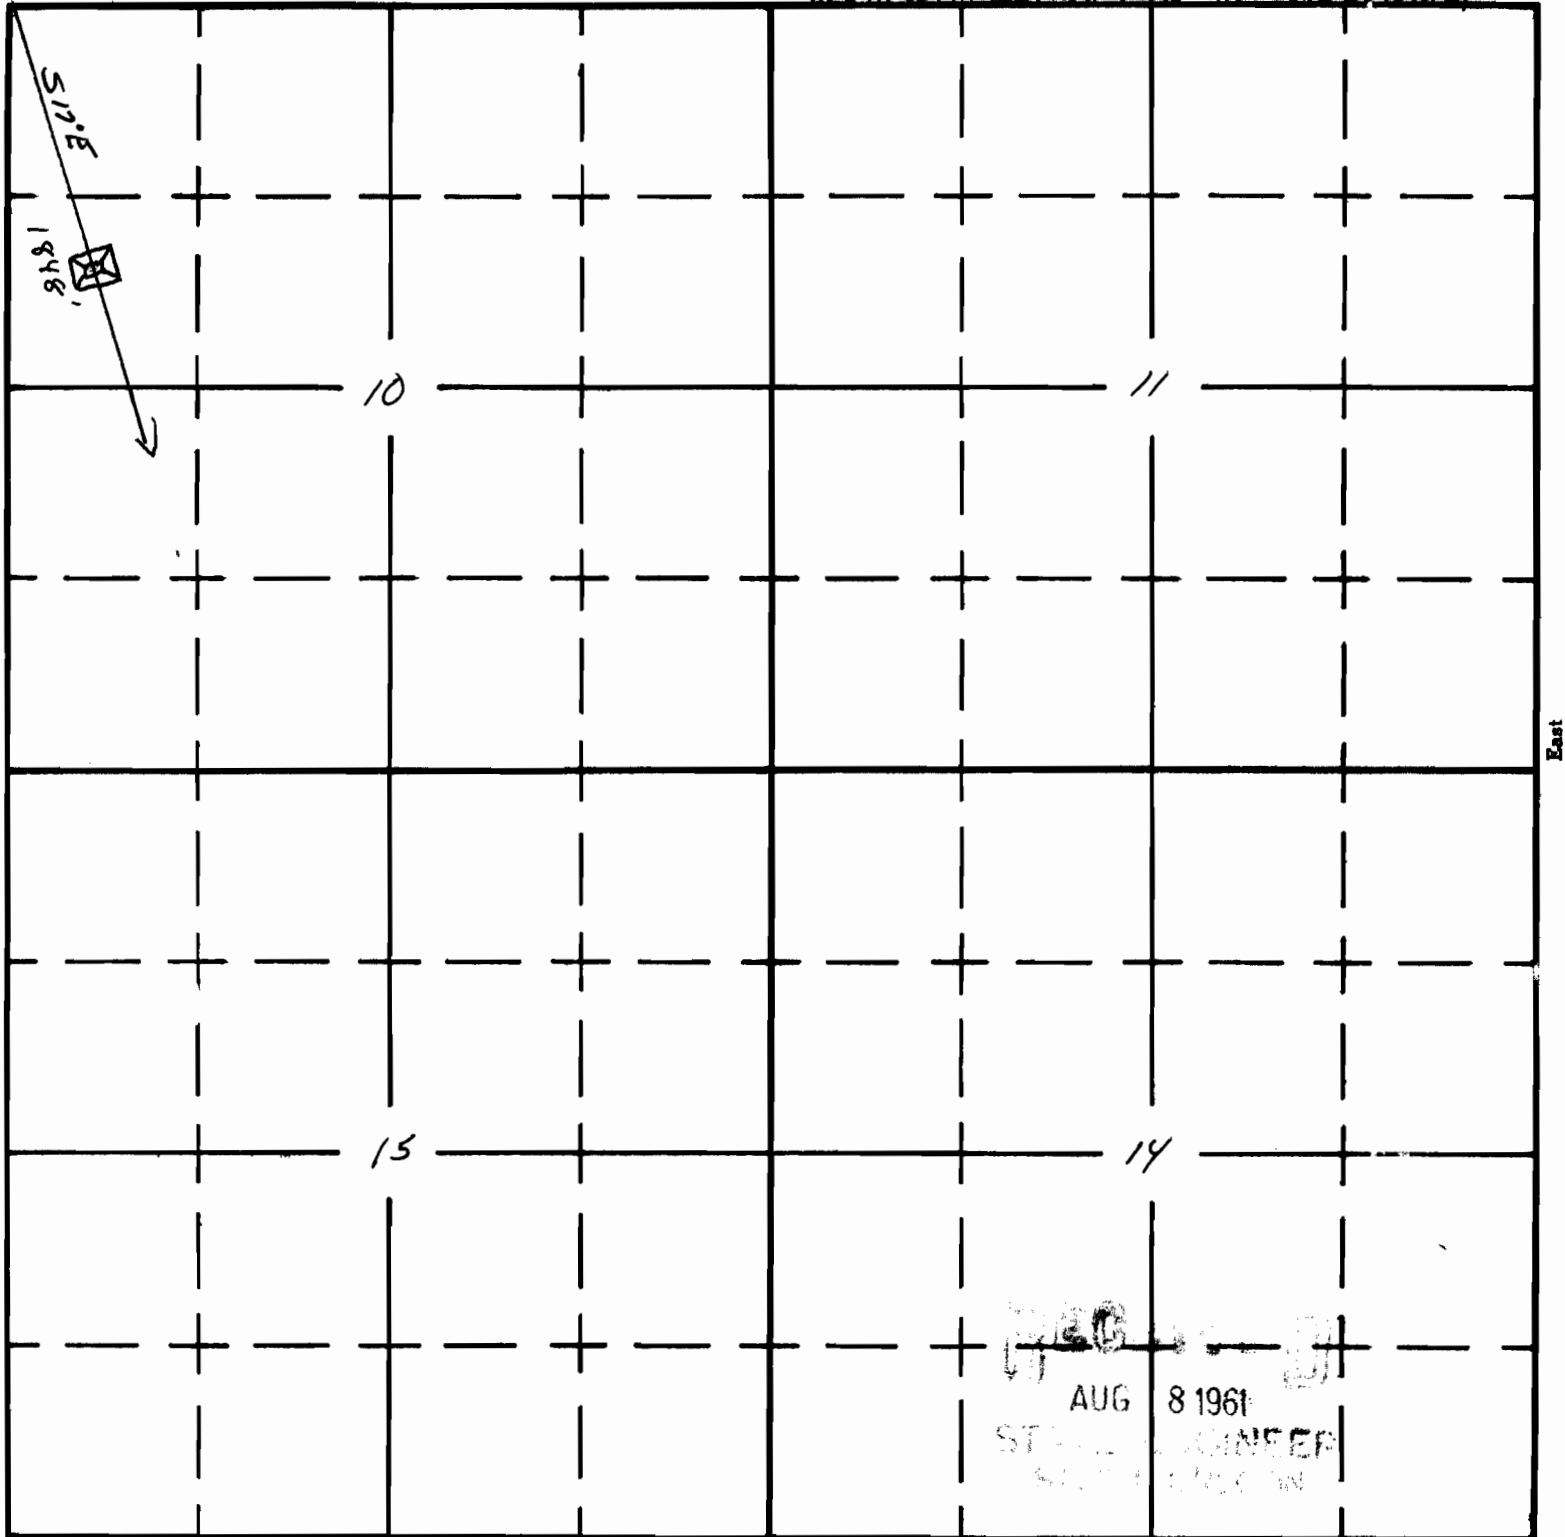

APPLICATION No. R-36538
PERMIT No. R-4246