

UNITED STATES
DEPARTMENT OF THE INTERIOR
BUREAU OF LAND MANAGEMENT


SECTION 6

Oregon State Water Filings

NW 1/4 SW 1/4

TOWNSHIP 40S, RANGE 26E, W. M.

North

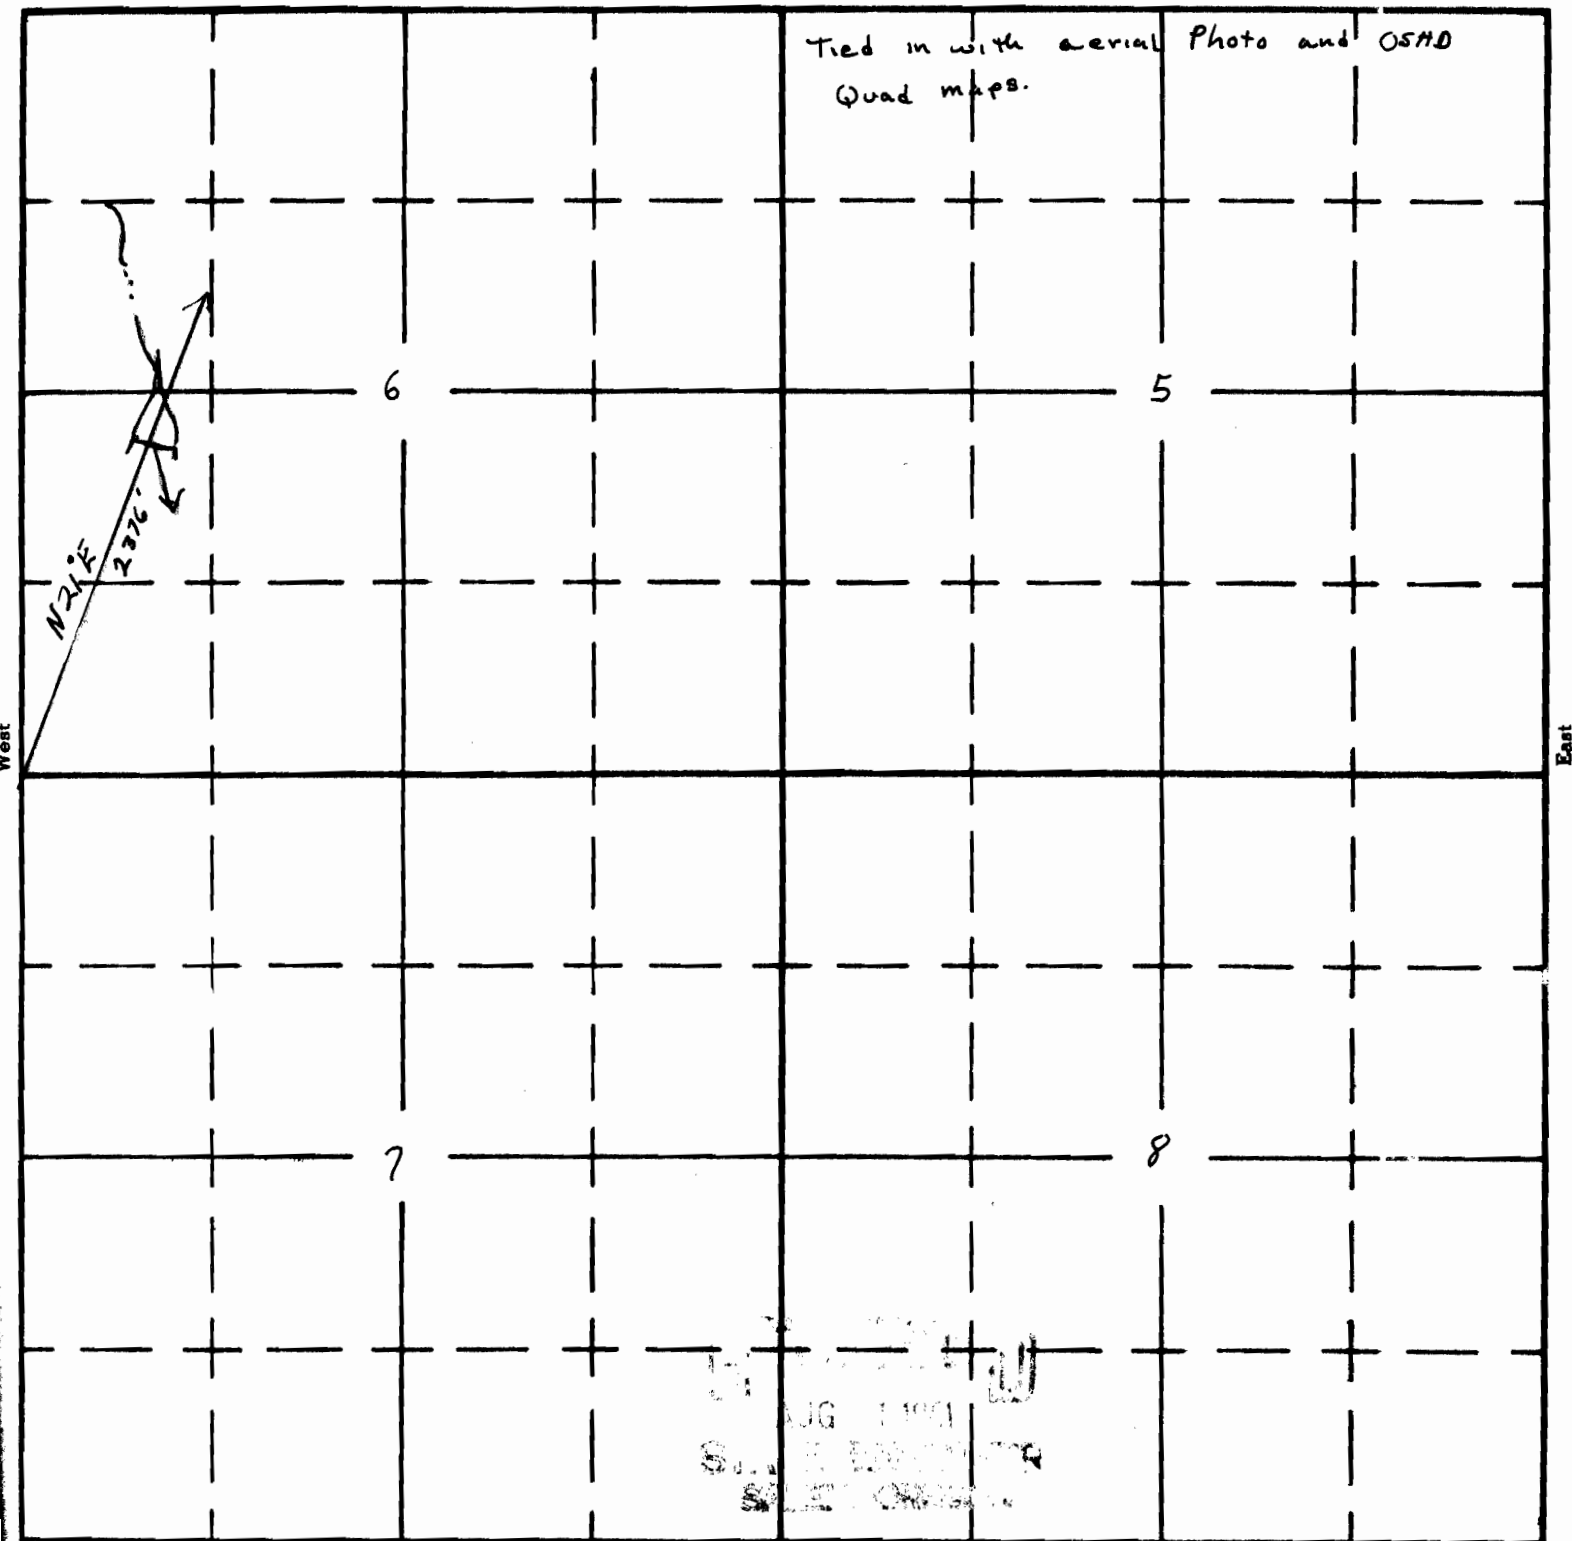

South

APPLICATION No. R-36012