

UNITED STATES
DEPARTMENT OF THE INTERIOR
BUREAU OF LAND MANAGEMENT


SECTION 10

Oregon State Water Filings

SE 1/4 NW 1/4

TOWNSHIP 39S, RANGE 28E, W. M.

Used in with aerial photos in D.S.H.D. Quad Map

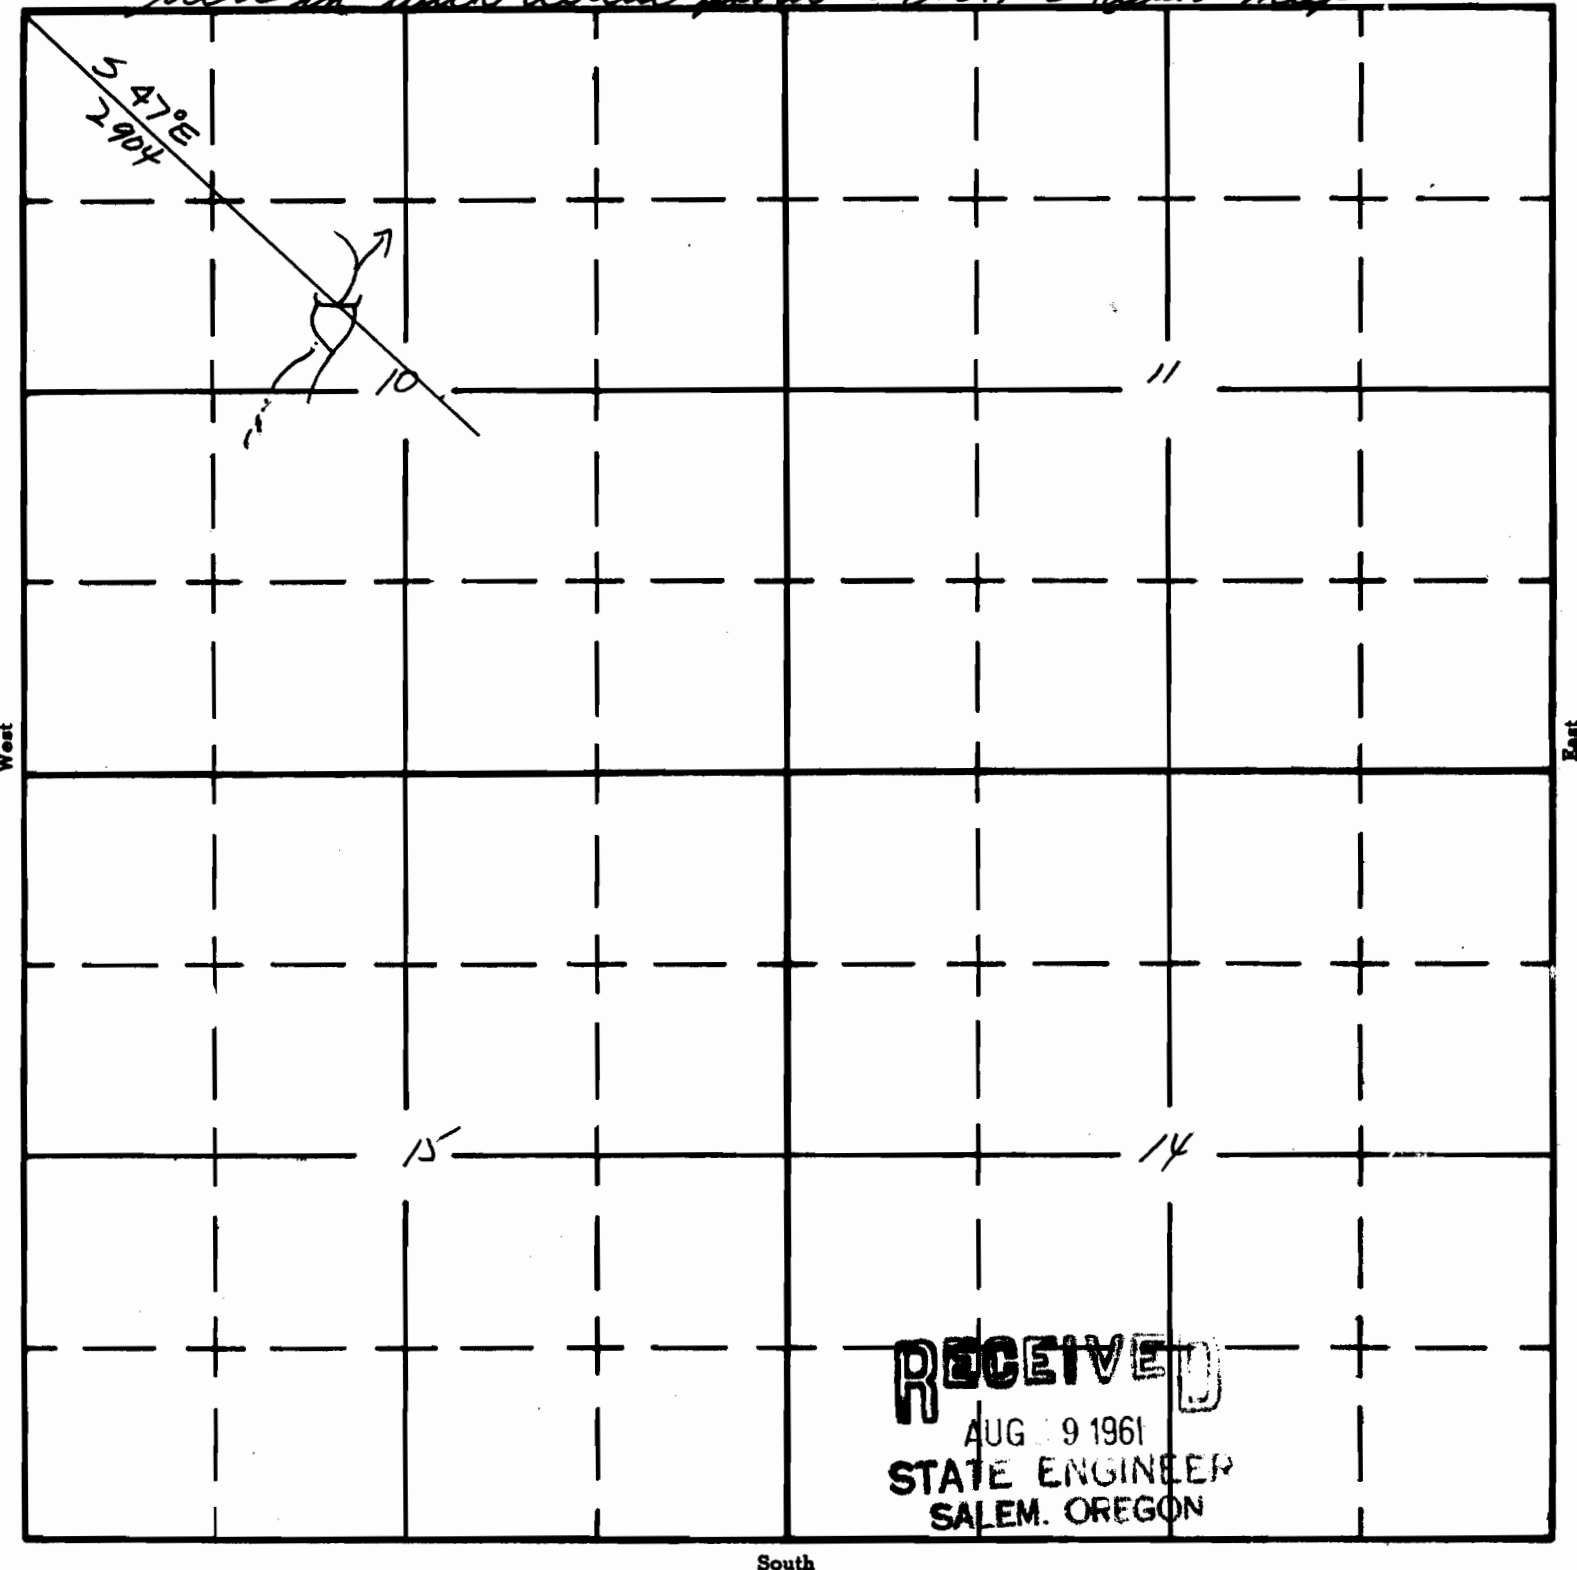

APPLICATION No. R-36942
PERMIT No. R-4378