


Oregon State Water Filings

TOWNSHIP 23S, RANGE 19E, W. M.

North

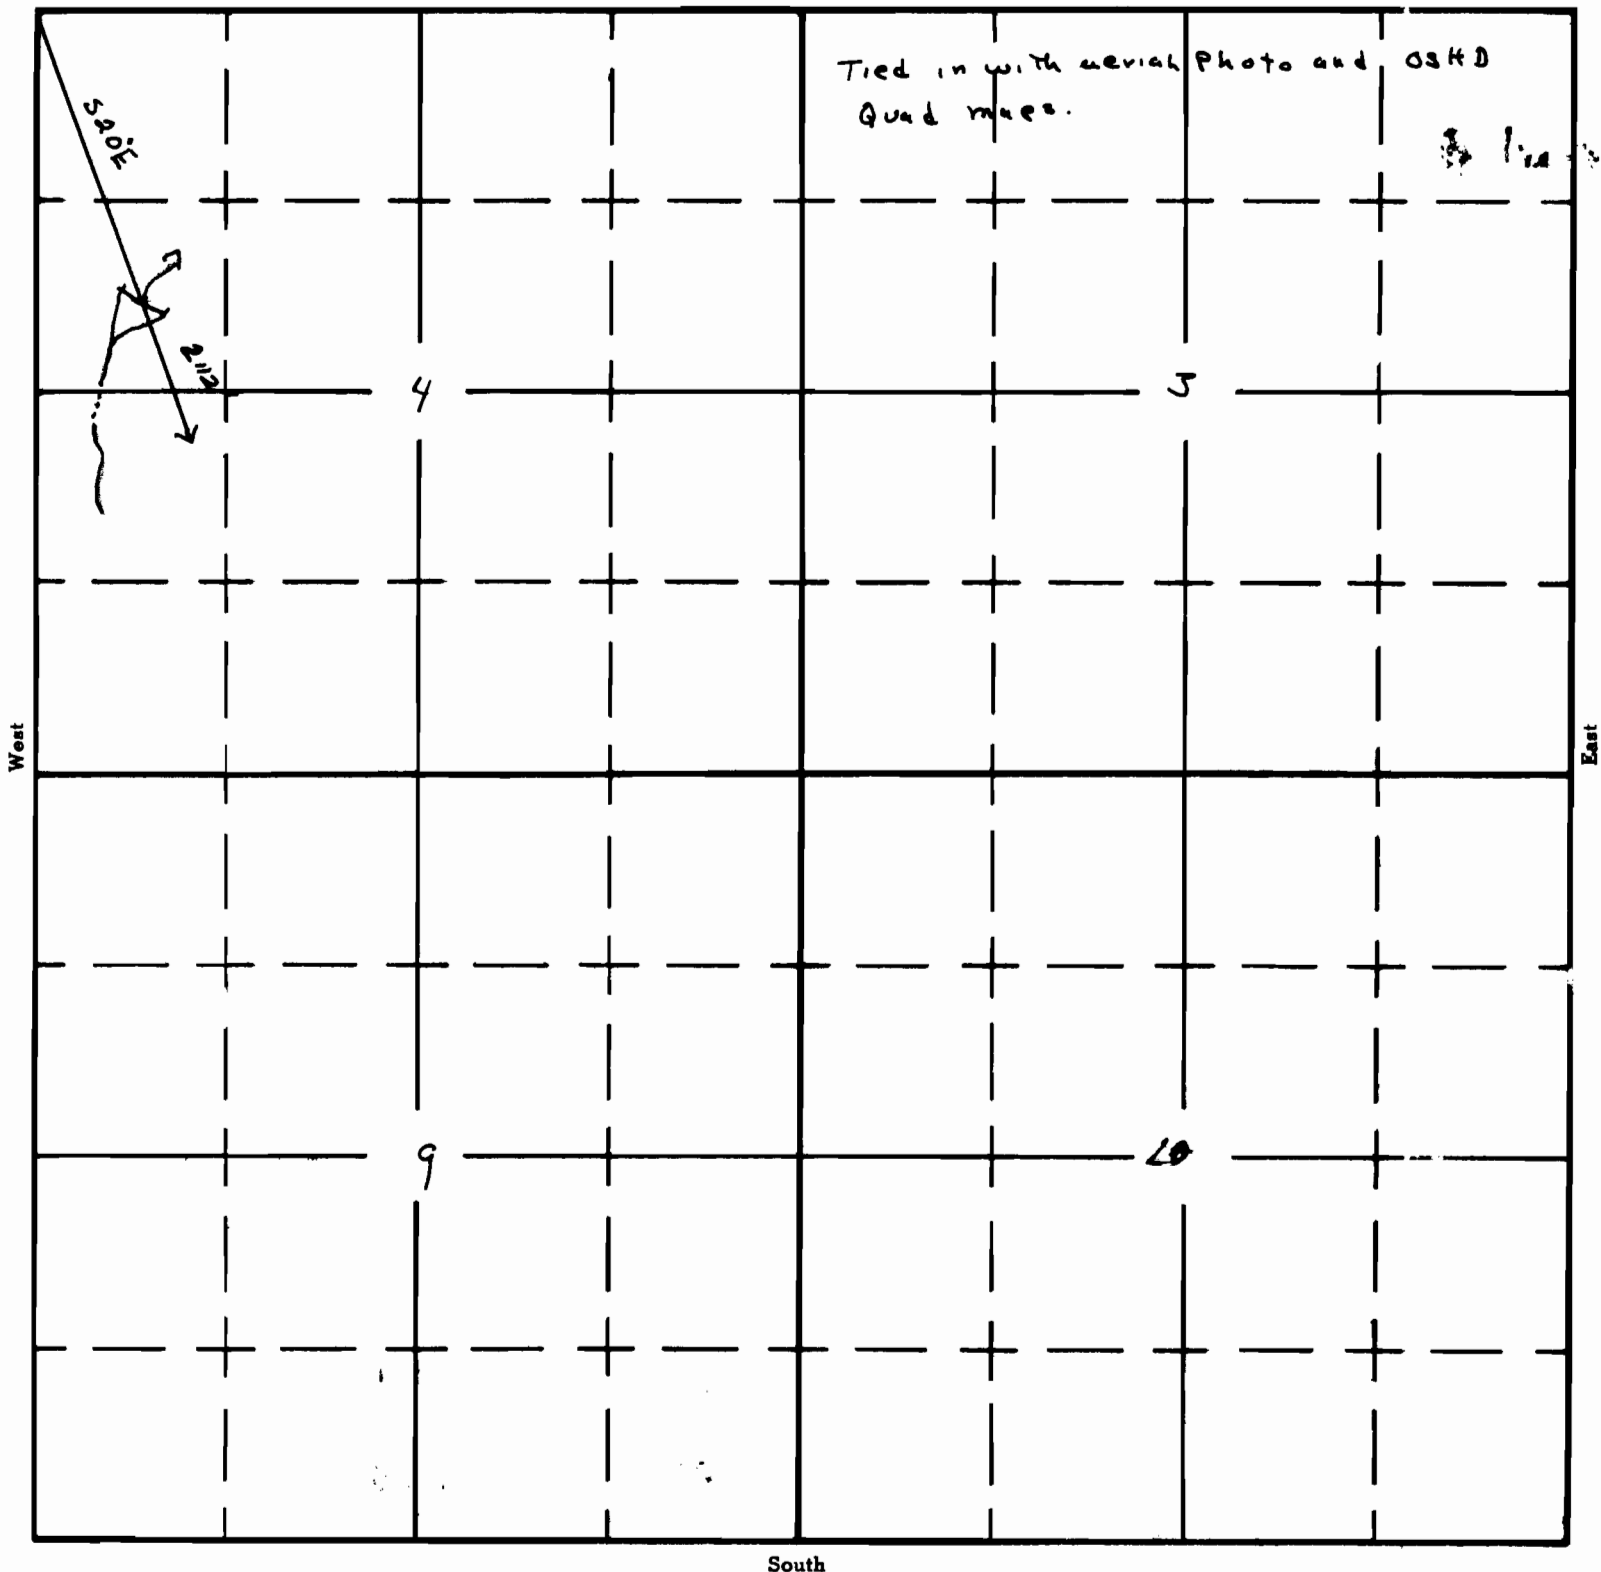

South

APPLICATION No. R-35720

PERMIT No. 4 6238