

Form AI-187
March 1961

UNITED STATES
DEPARTMENT OF THE INTERIOR
BUREAU OF LAND MANAGEMENT

SECTION


//

Oregon State Water Filings

SE 1/4 NE 1/4

TOWNSHIP 31 S, RANGE 26 E, W. M.

Tied in with aerial photos and O.S.H.D. Quad Maps

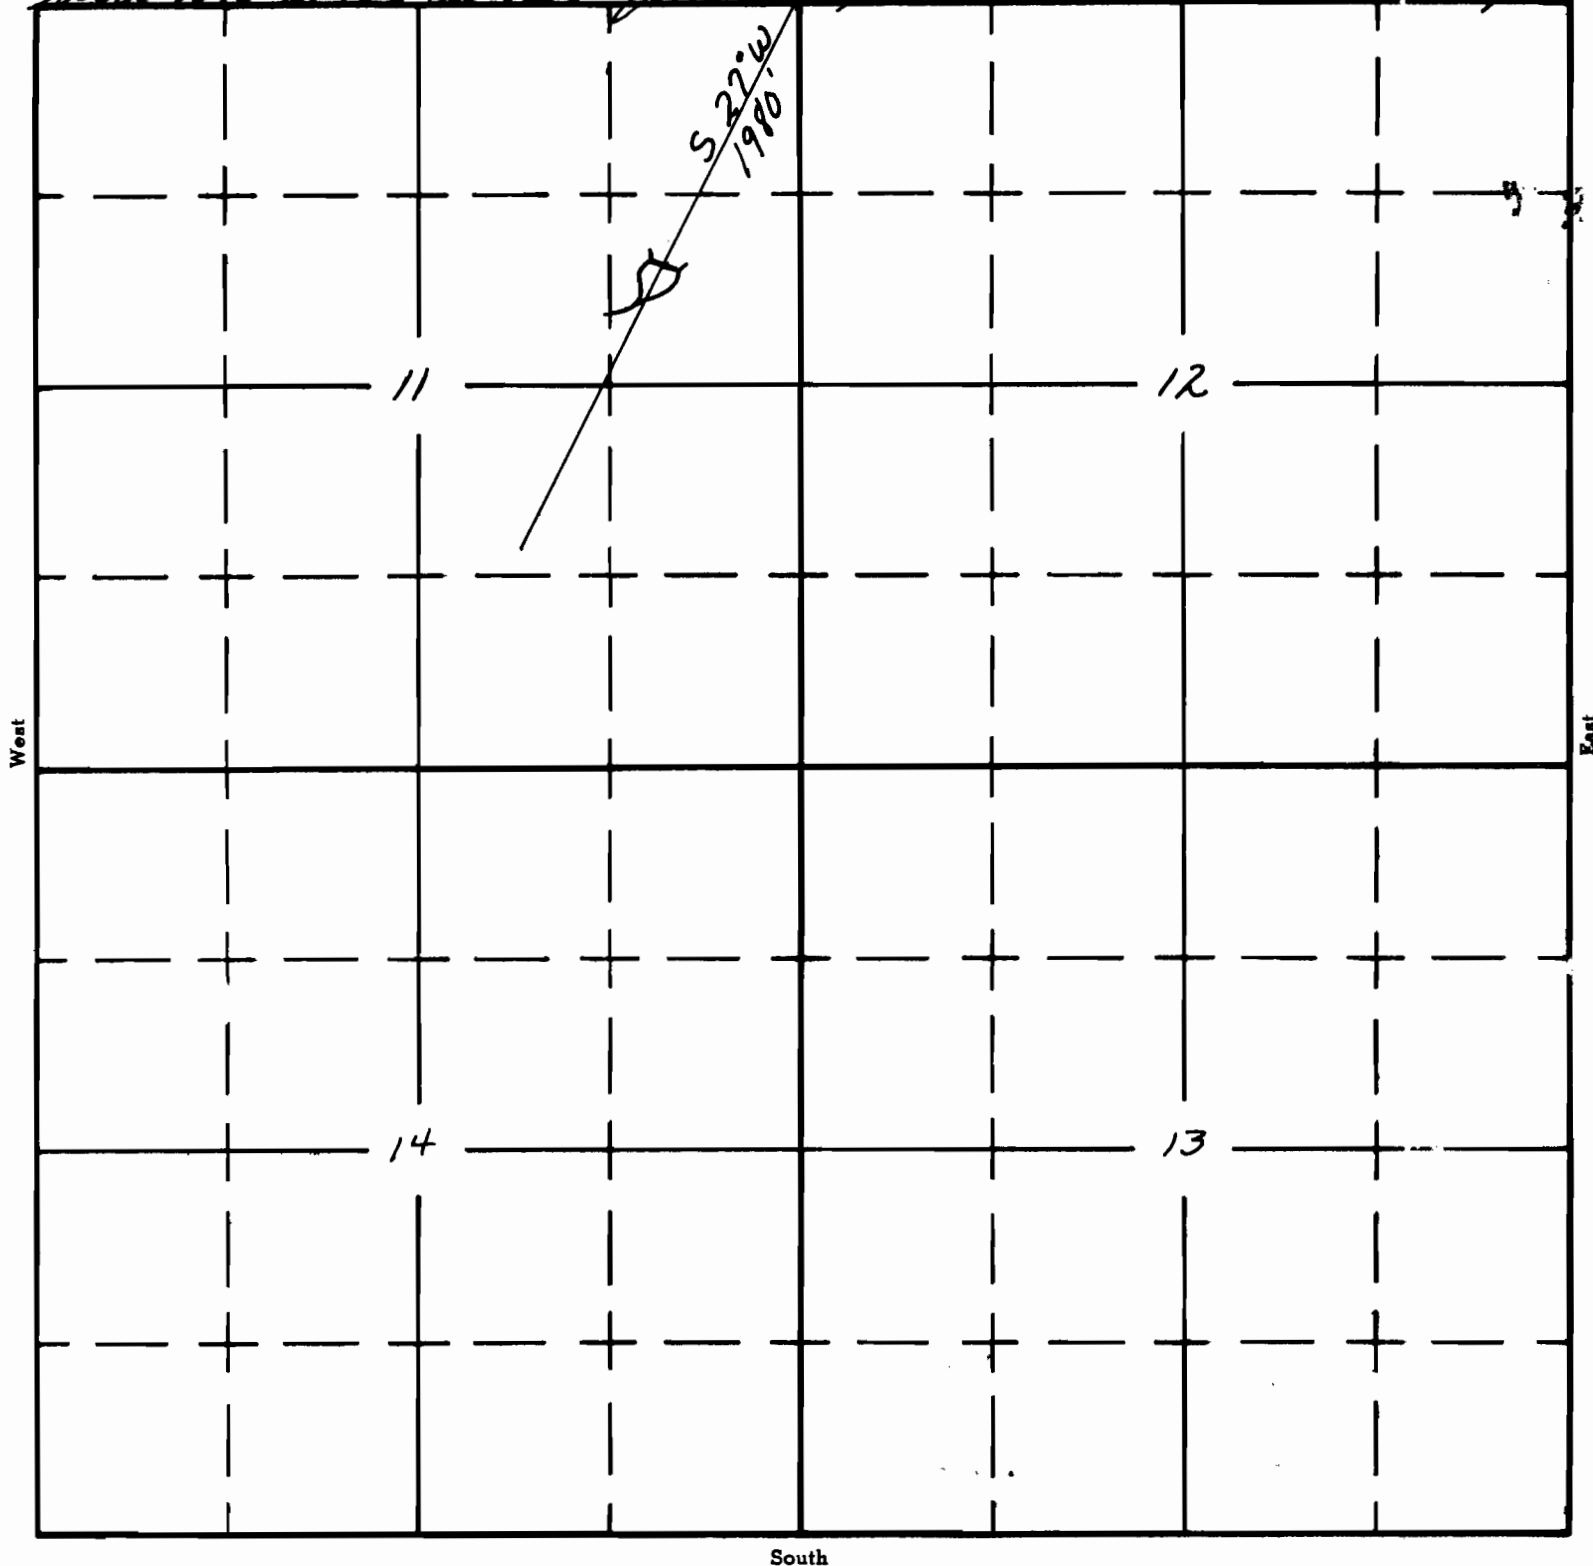

APPLICATION No. R-35735

PERMIT No. 1 6849