

UNITED STATES  
DEPARTMENT OF THE INTERIOR  
BUREAU OF LAND MANAGEMENT

R-6843  
78630

SECTION

7 & 8



TOWNSHIP 31 S, RANGE 26 E, W. M.

NE  $\frac{1}{4}$  SE  $\frac{1}{4}$

NW  $\frac{1}{4}$  SW  $\frac{1}{4}$

*Tied-in with aerial photos & O.S.H.D. Quad Maps.*

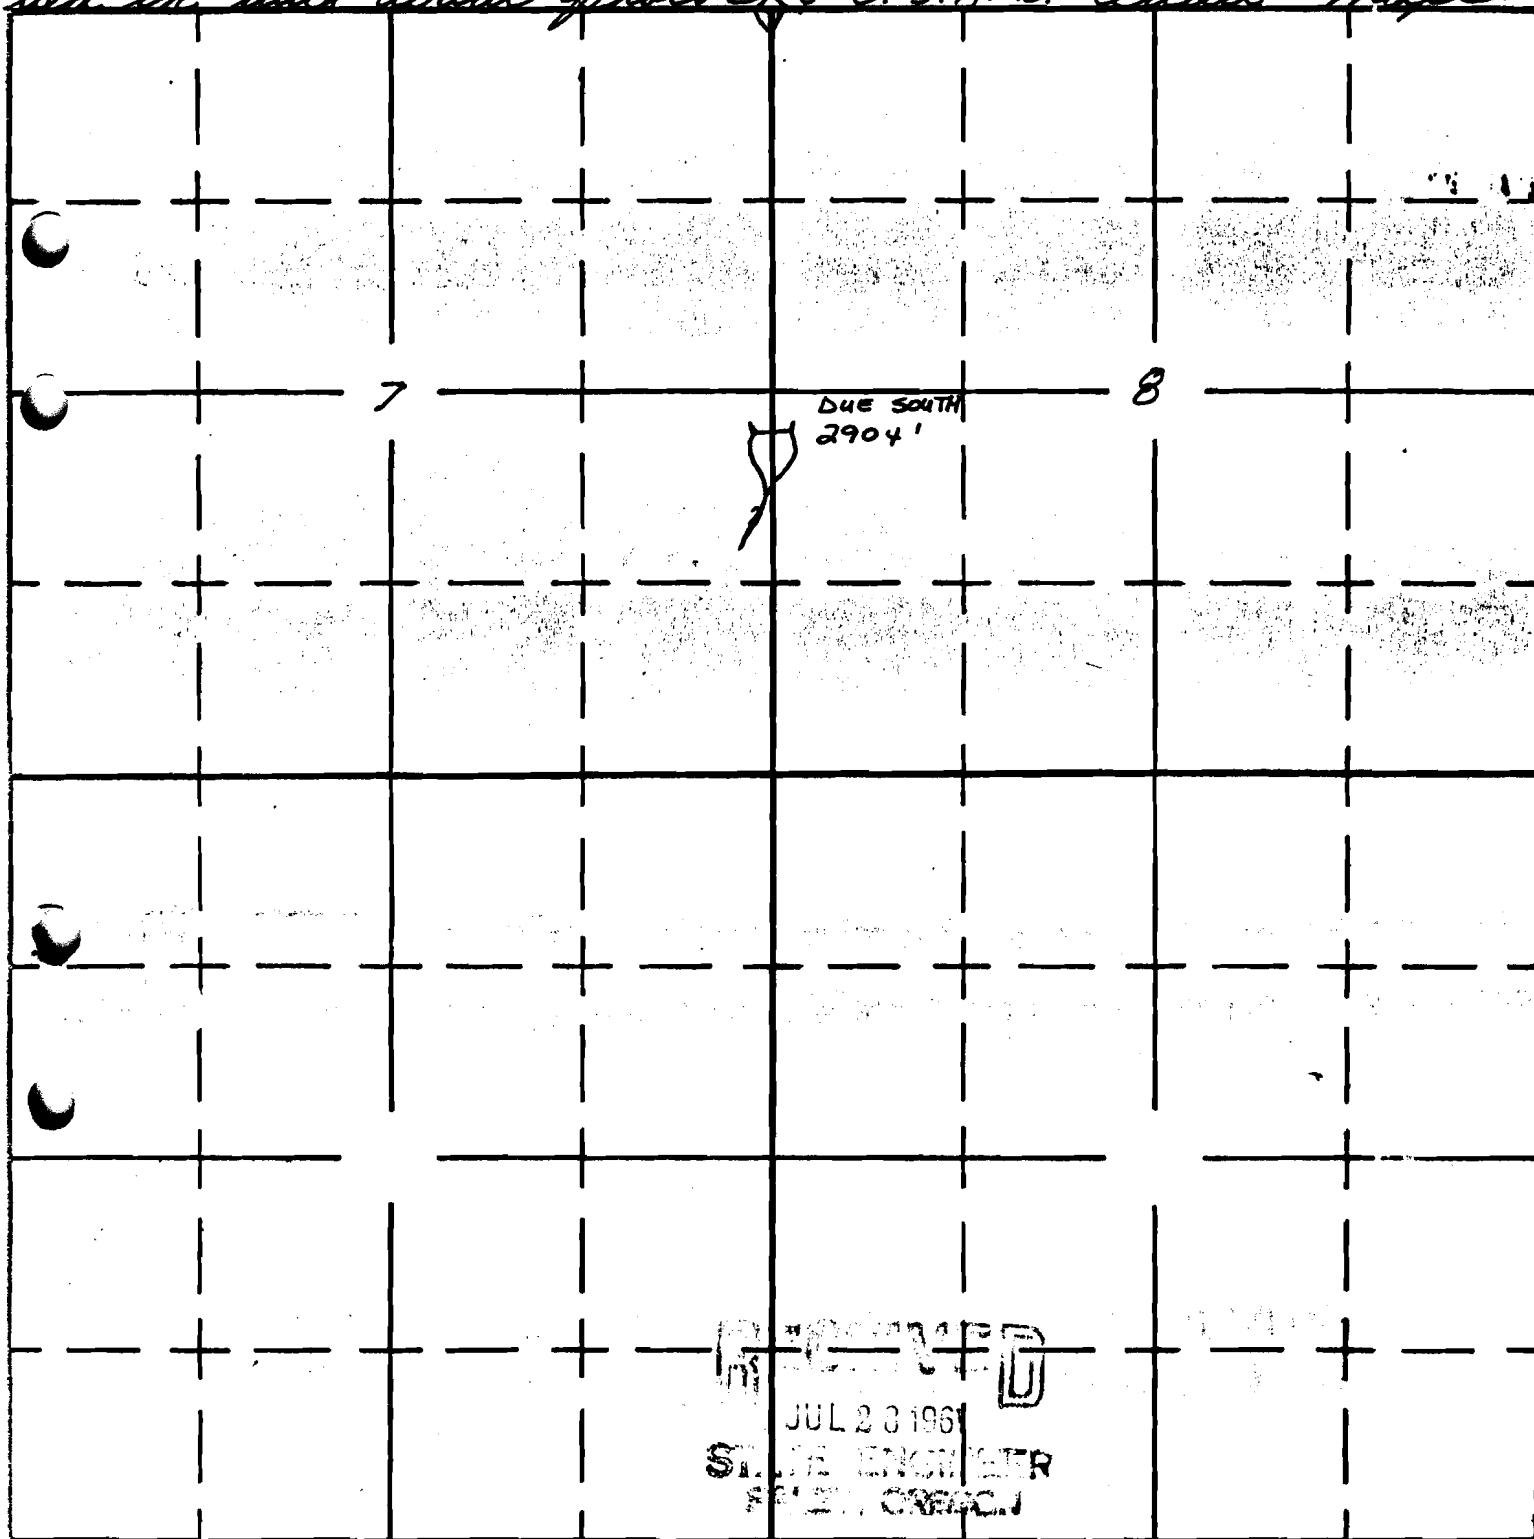

RECEIVED  
JUL 23 1961  
STATE ENGINEER  
PORTLAND, OREGON

APPLICATION No. R-35737

PERMIT No. **6843**