

UNITED STATES
DEPARTMENT OF THE INTERIOR
BUREAU OF LAND MANAGEMENT

R-6954
78634


SECTION 1

Oregon State Water Filings

NW 1/4 NW 1/4

TOWNSHIP 39 S, RANGE 25 E, W. M.

Tied in with aerial photos and U.S.H.D. Quad Maps.

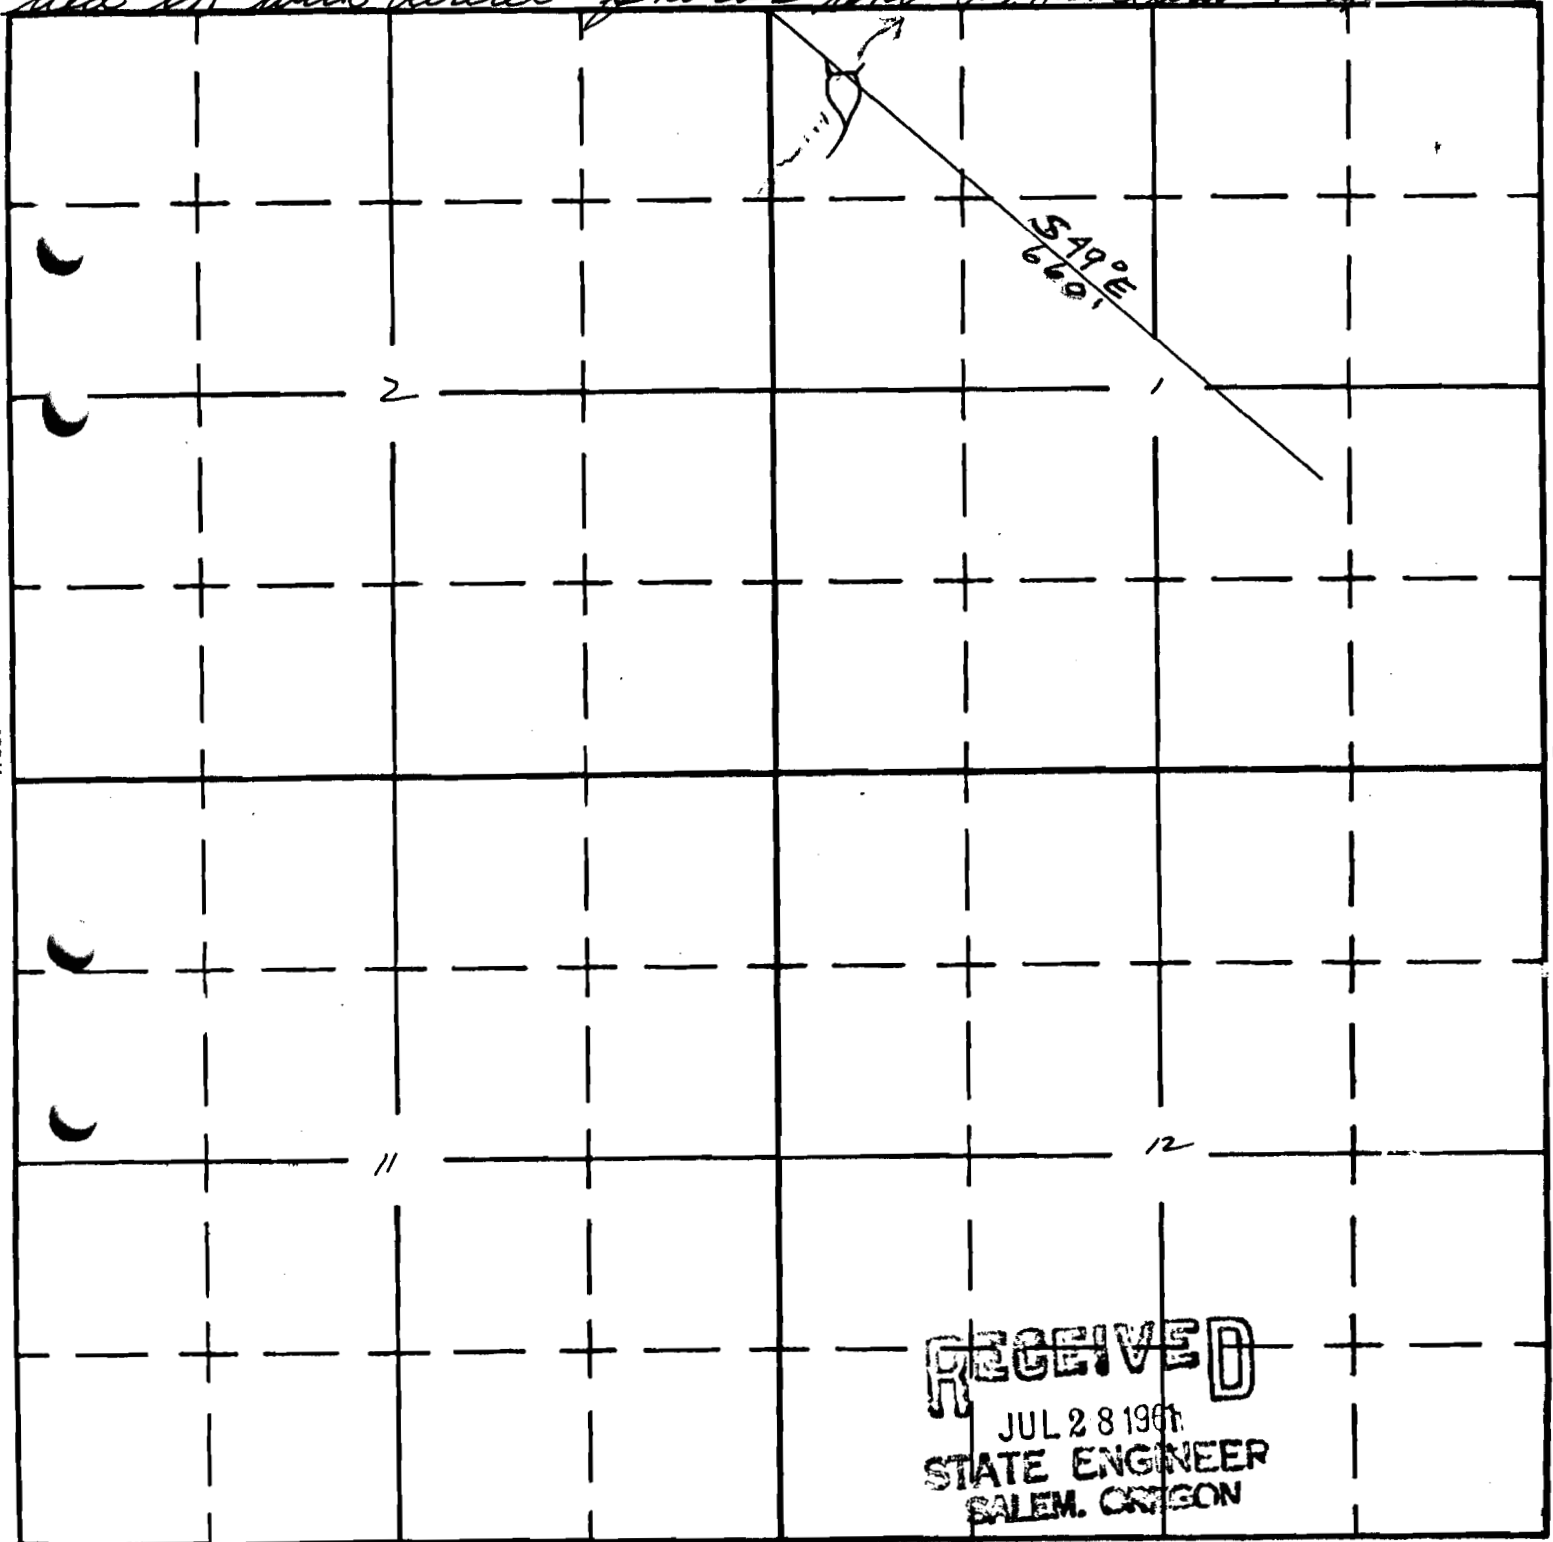

APPLICATION No. R-35798
PERMIT No. **R 6954**