

Form A1-187
March 1961

UNITED STATES
DEPARTMENT OF THE INTERIOR
BUREAU OF LAND MANAGEMENT

R-6960
78635

SECTION


4

SW $\frac{1}{4}$ SE $\frac{1}{4}$

Oregon State Water Filings

TOWNSHIP 39S, RANGE 26E, W. M.

North

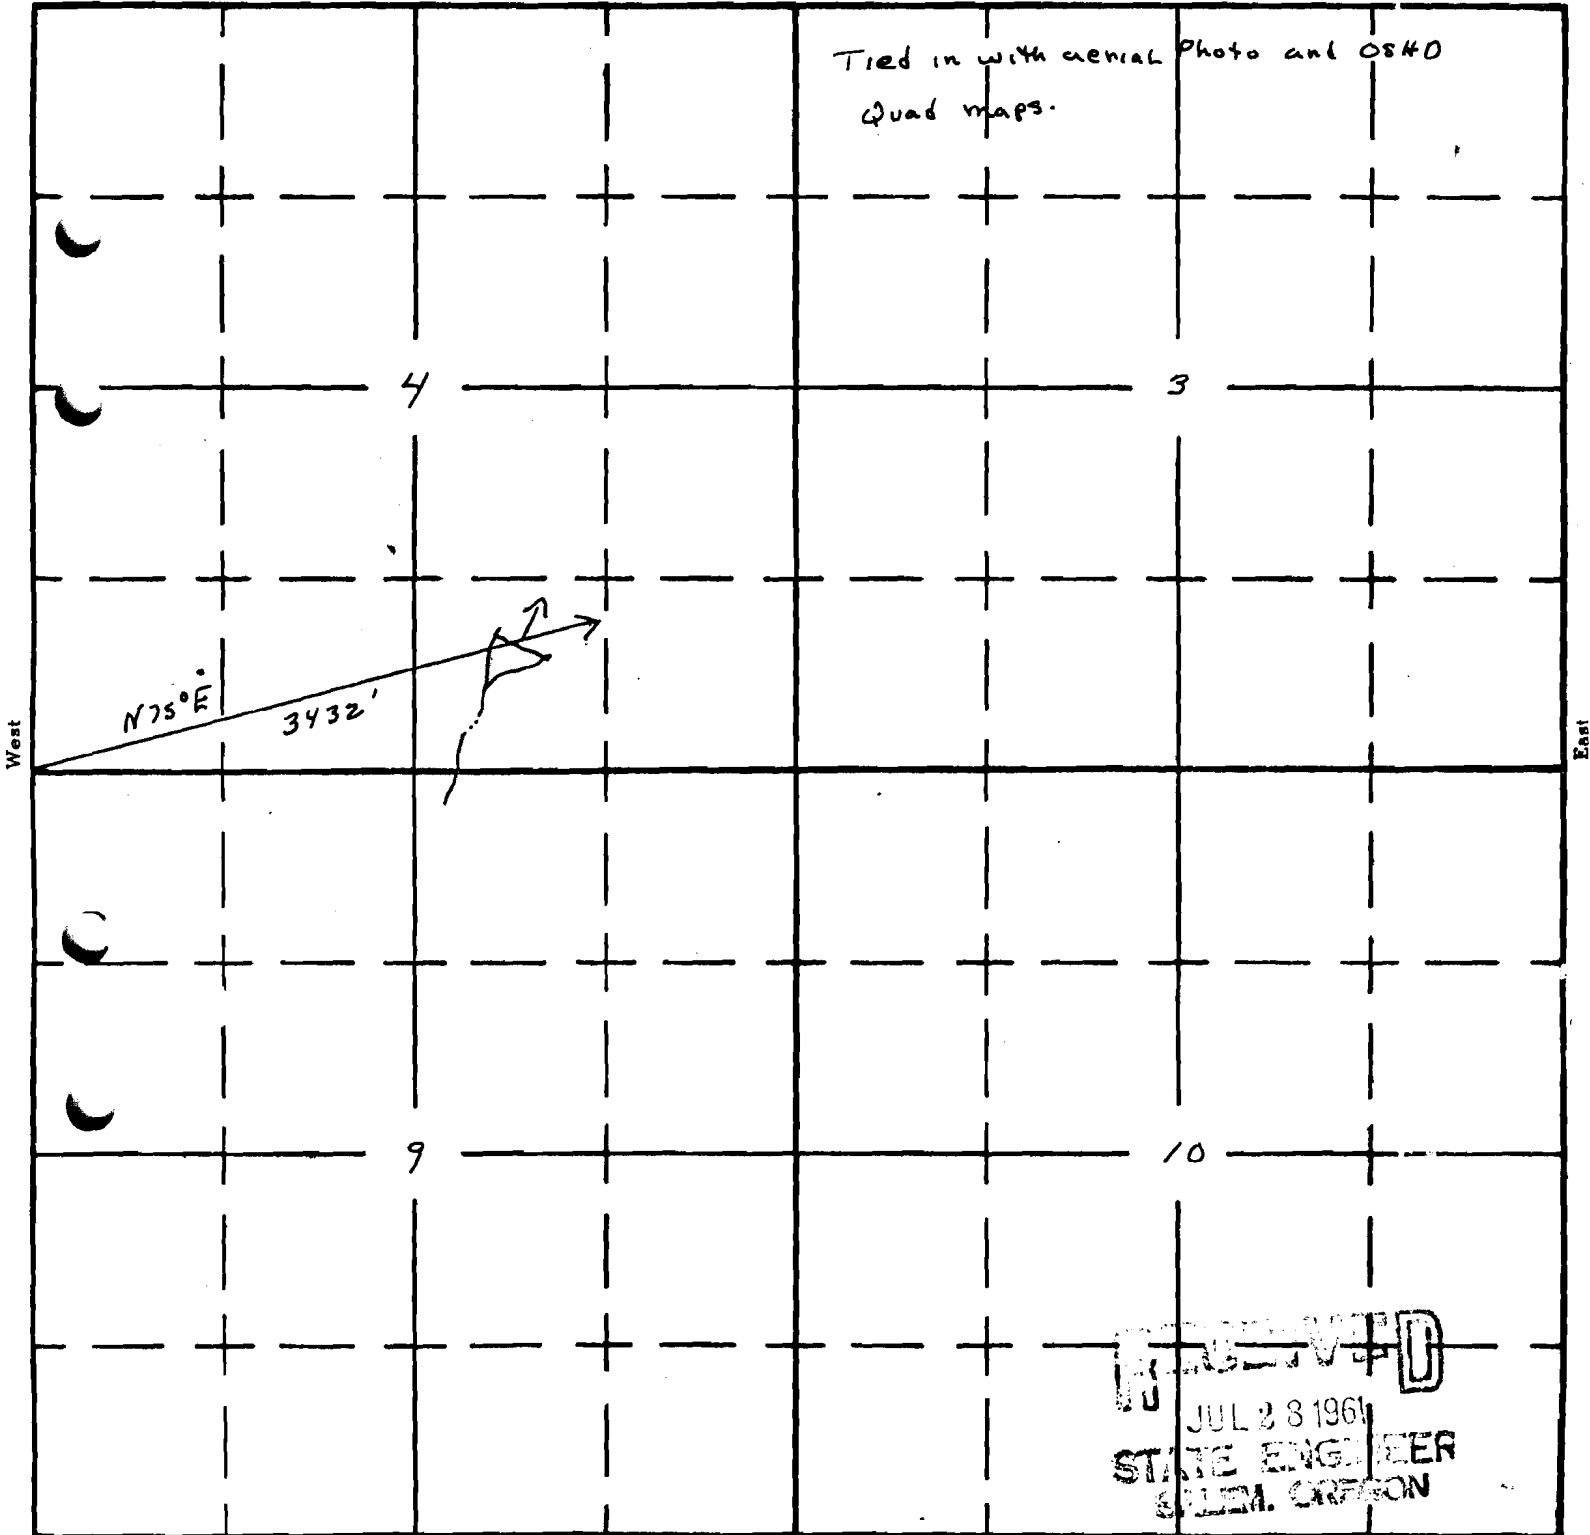

South

APPLICATION No. R-35804

PERMIT No. **6960**