

UNITED STATES
DEPARTMENT OF THE INTERIOR
BUREAU OF LAND MANAGEMENT

R-6962
78636

SECTION

3


NE 1/4 SW 1/4

Oregon State Water Filings

TOWNSHIP 39S, RANGE 26E, W. M.

North

Tied in with aerial Photo and
OSHD Quad maps.

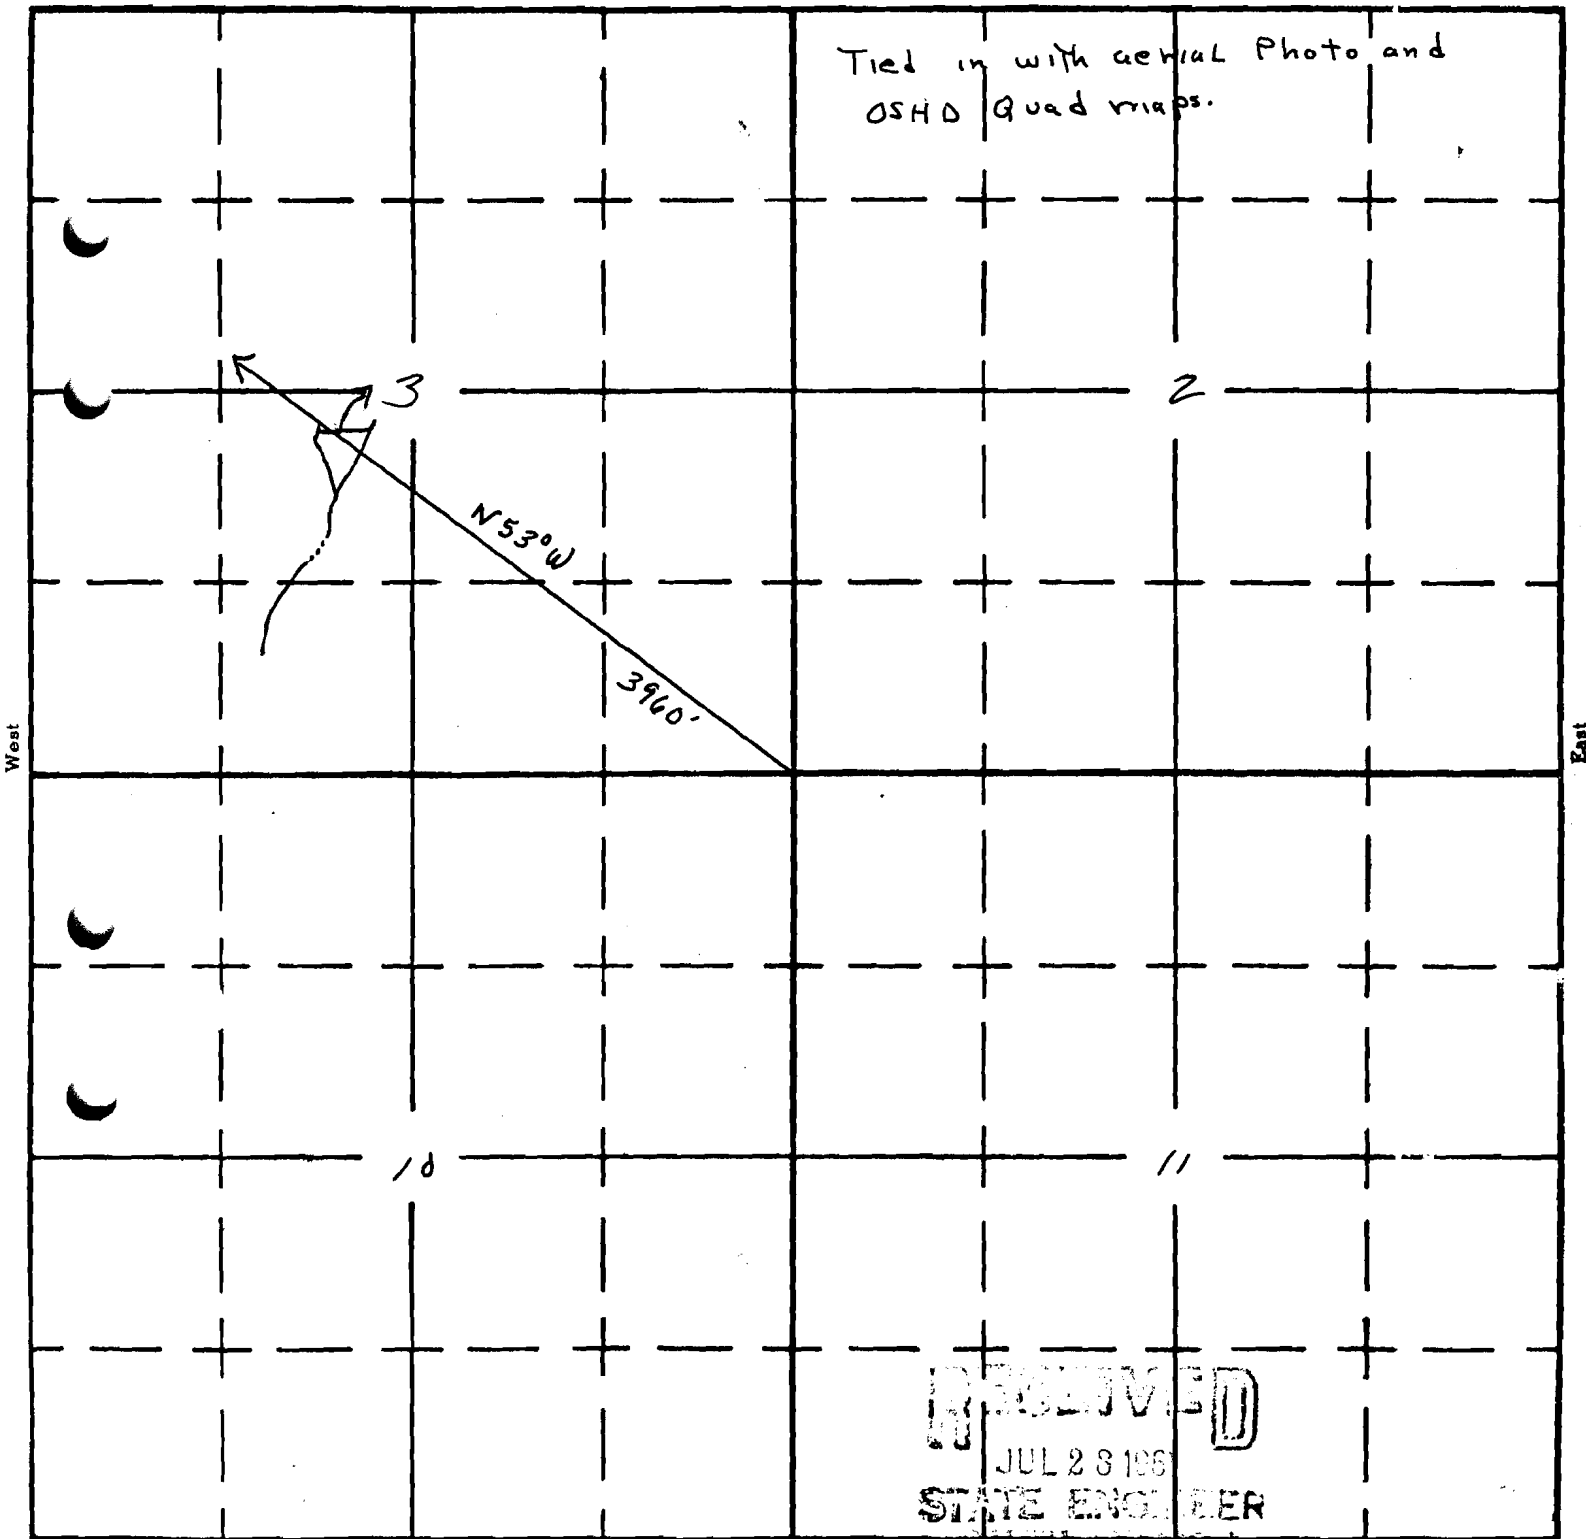

South

APPLICATION No. R-35306

PERMIT No. R 6962