

UNITED STATES
DEPARTMENT OF THE INTERIOR
BUREAU OF LAND MANAGEMENT

SECTION


4

Oregon State Water Filings

NW¹/₄ NW¹/₄

TOWNSHIP 35 S, RANGE 23 E, W. M.

Tied in with aerial photo North: D.S.H.D. Quad Map

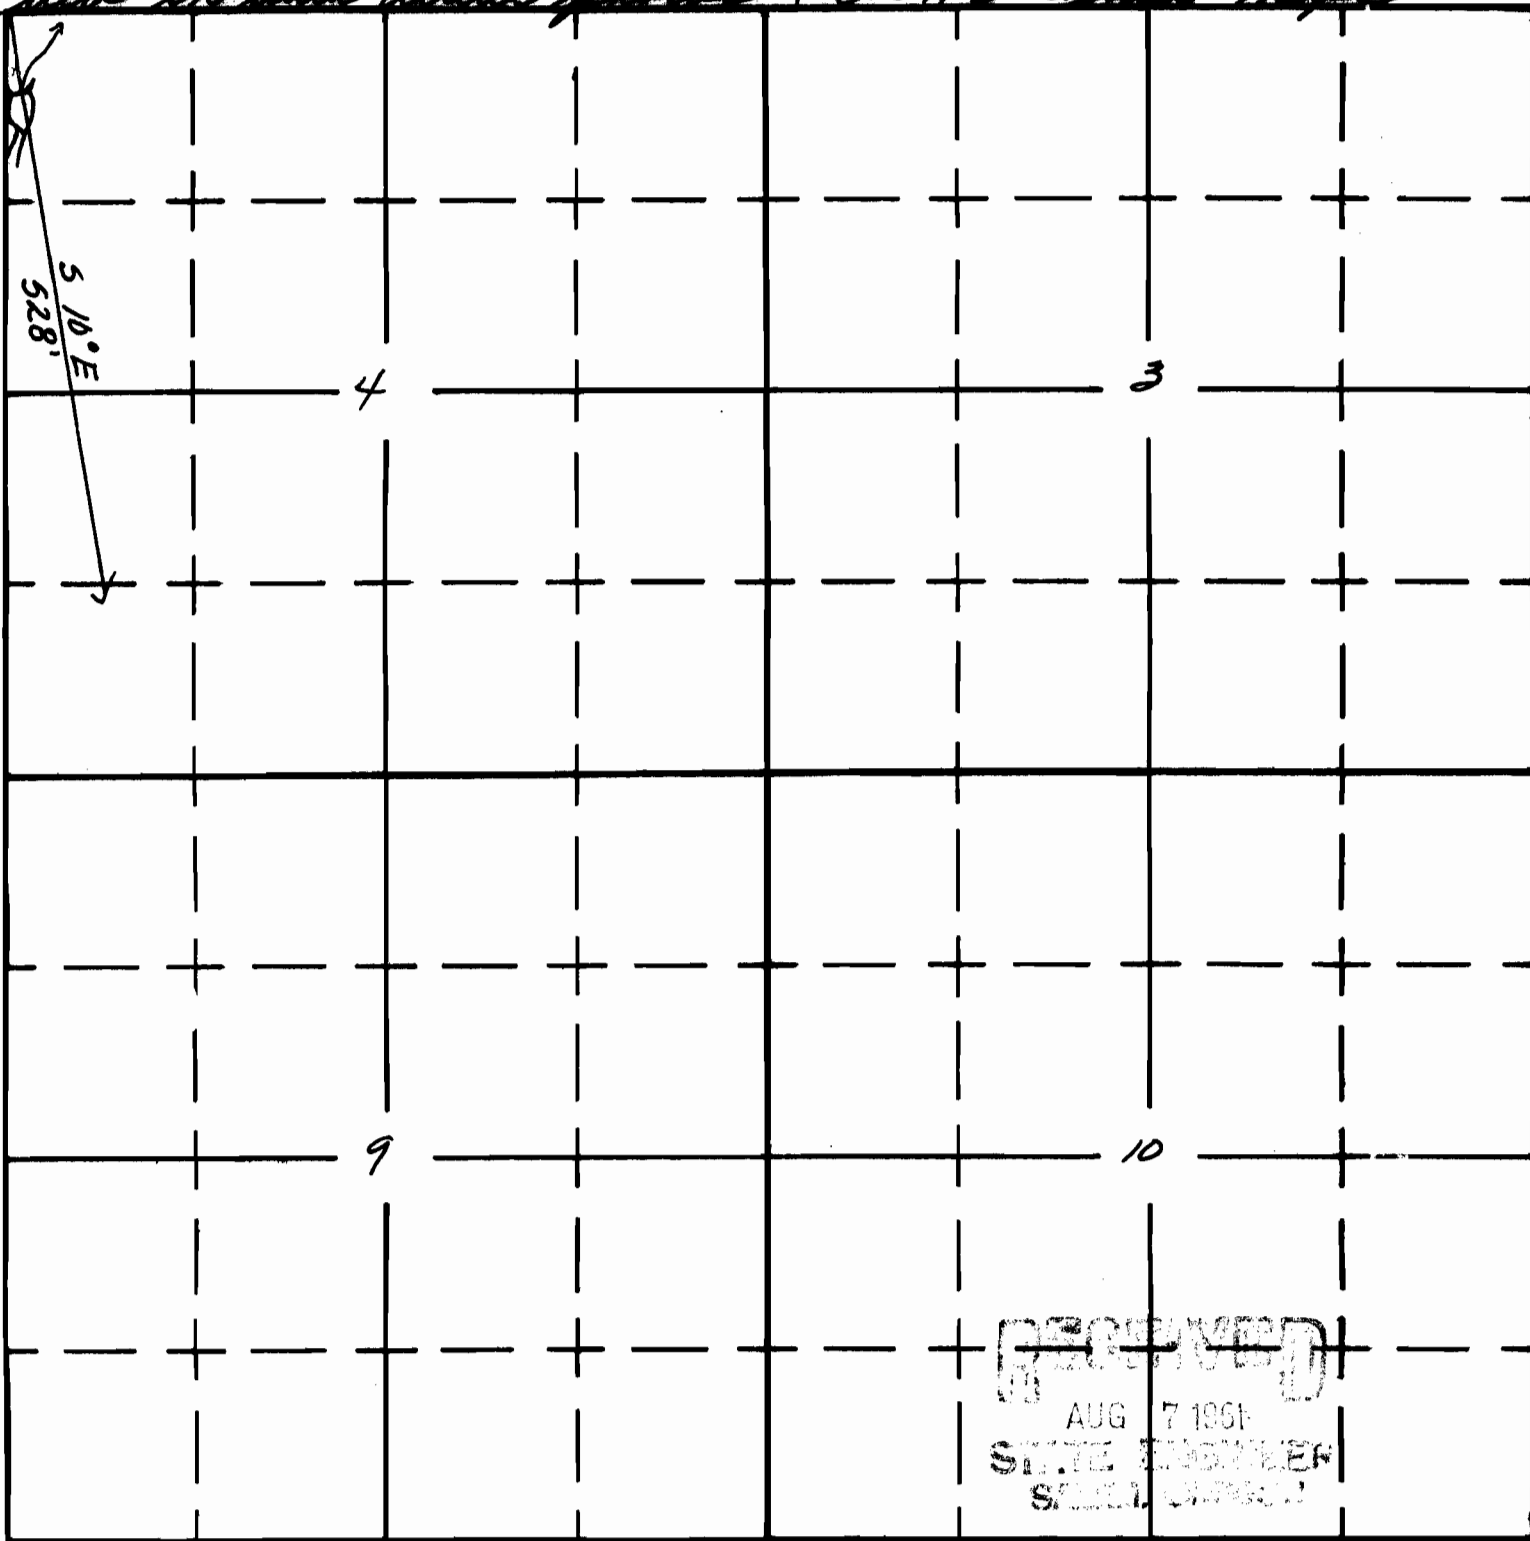

South

APPLICATION No. R-36222

PERMIT No. R 7069