

Form AI-187

March 1961

Section

16


NW 1/4 SW 1/4

UNITED STATES
DEPARTMENT OF THE INTERIOR
Bureau of Land Management

OREGON STATE WATER FILINGS

Township 30S, Range 25E, W.M.

North *Tied in with aerial photo and USND Quad map.*

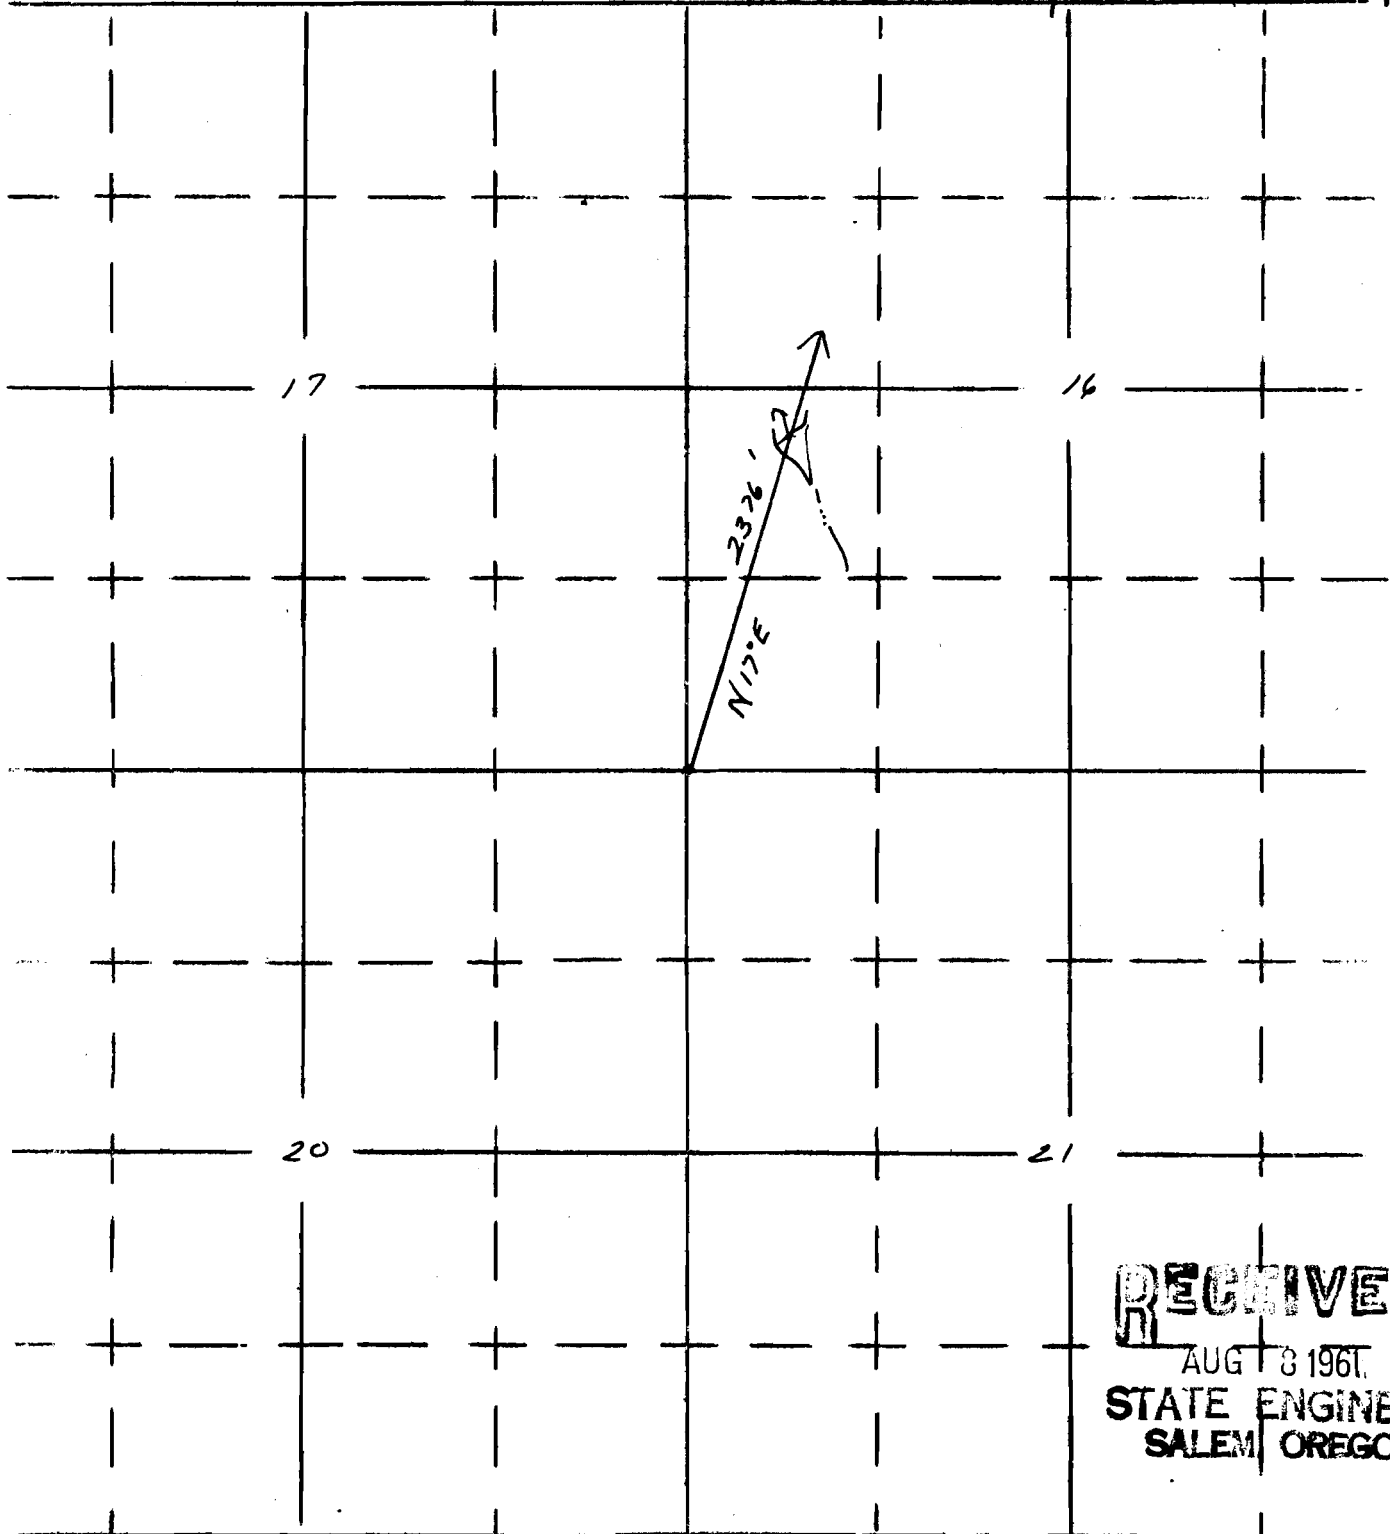

South

RECEIVED
AUG 8 1961
STATE ENGINEER
SALEM OREGON

Application No. 0-36360
Permit No. **R 7110**