

Form AI-187
March 1961

UNITED STATES
DEPARTMENT OF THE INTERIOR
BUREAU OF LAND MANAGEMENT


R-7154
78641

SECTION
28
NE 1/4 NW 1/4

Oregon State Water Filings

TOWNSHIP 32S, RANGE 23E, W. M.

North tied in with serial Plat and OS&D Quad Maps.

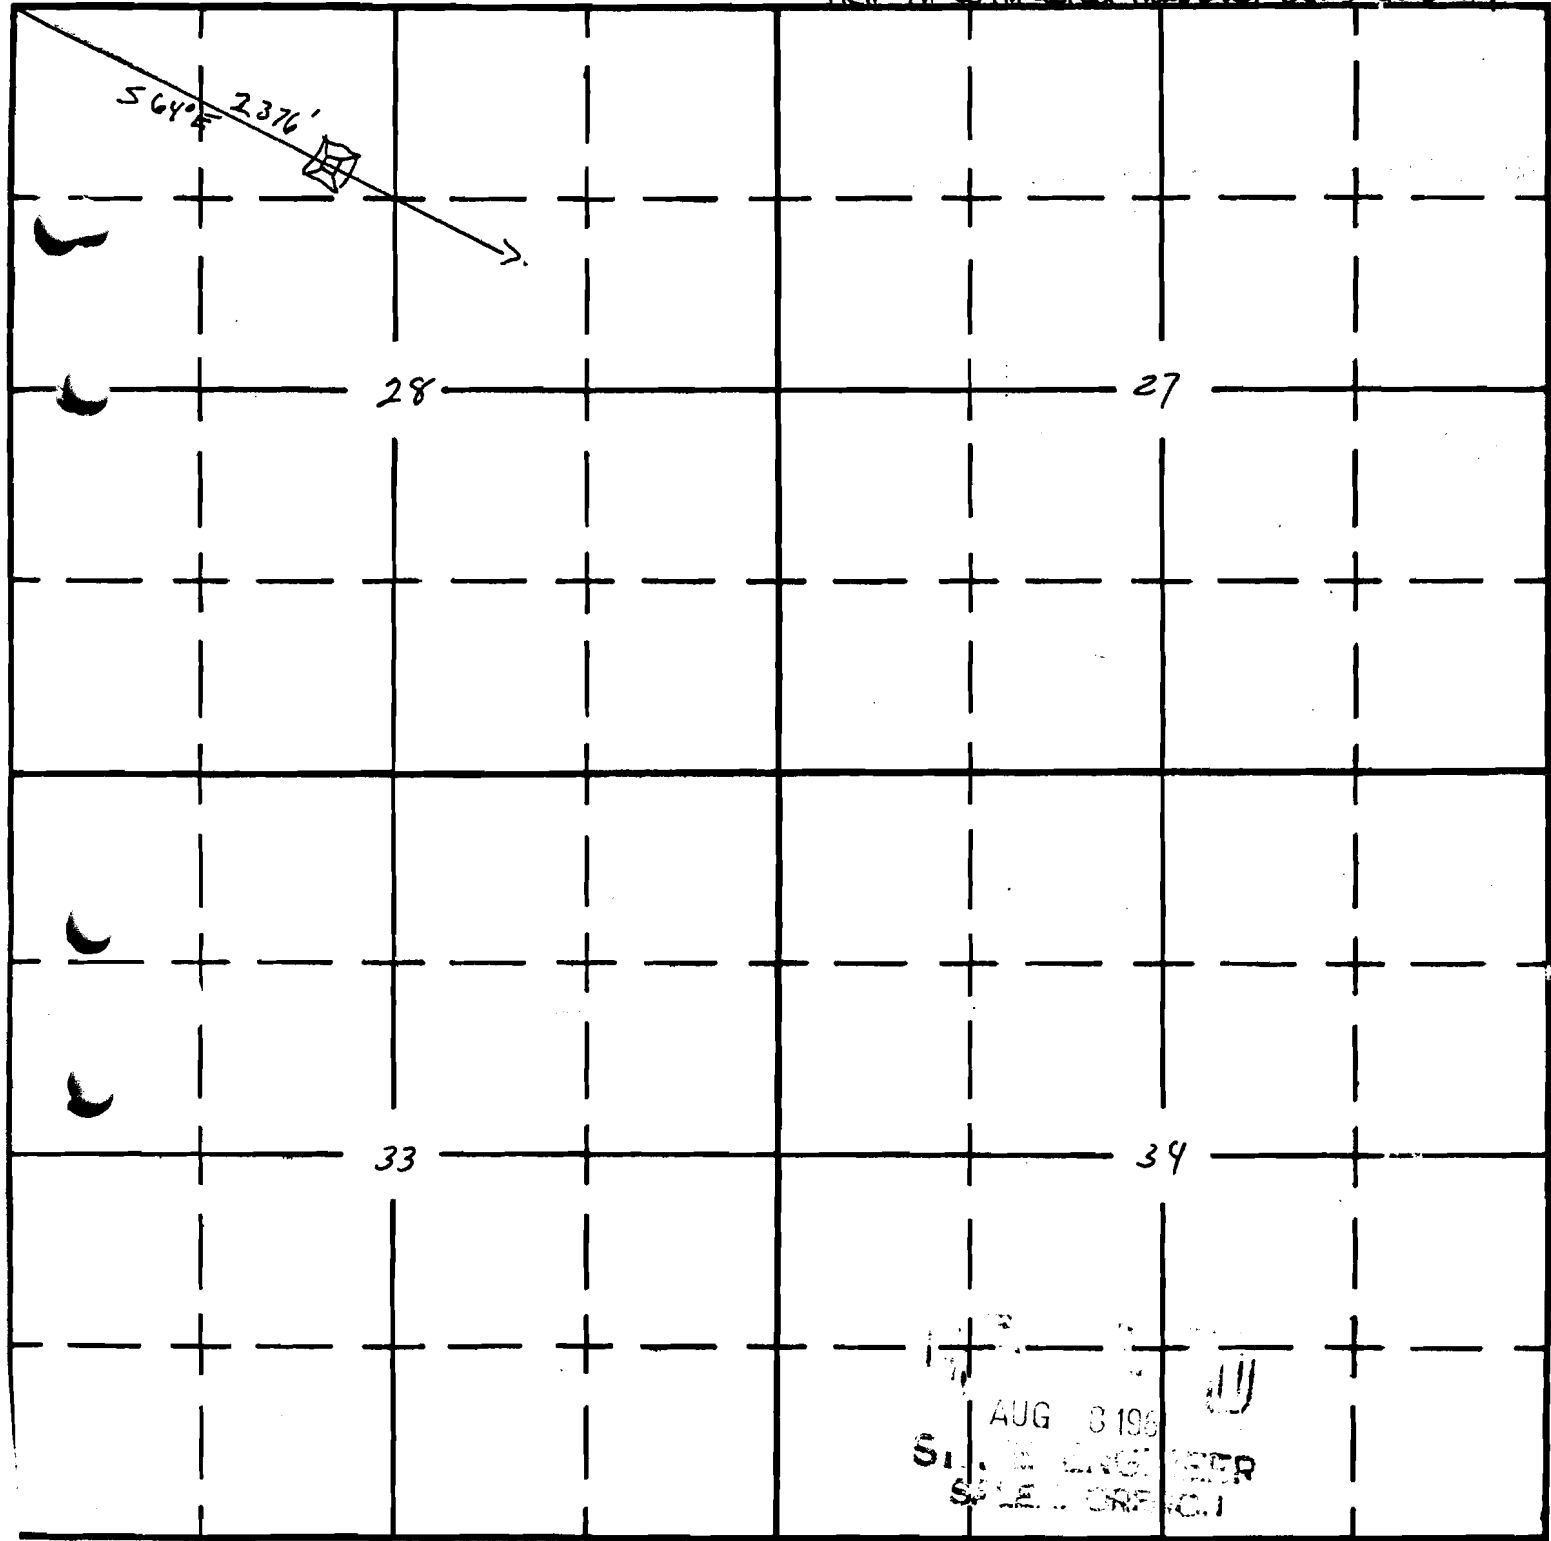

AUG 3 1961
S. E. ENGINEER

South

APPLICATION No. R-36426
PERMIT No. R-7154