Form A1-187
March 1961


UNITED STATES
DEPARTMENT OF THE INTERIOR
BUREAU OF LAND MANAGEMENT

SECTION 4
SE¼SE¼

Oregon State Water Filings

TOWNSHIP 38S, RANGE 23E, W. M.

North — Tied in with aerial photo and OSHD Road Maps

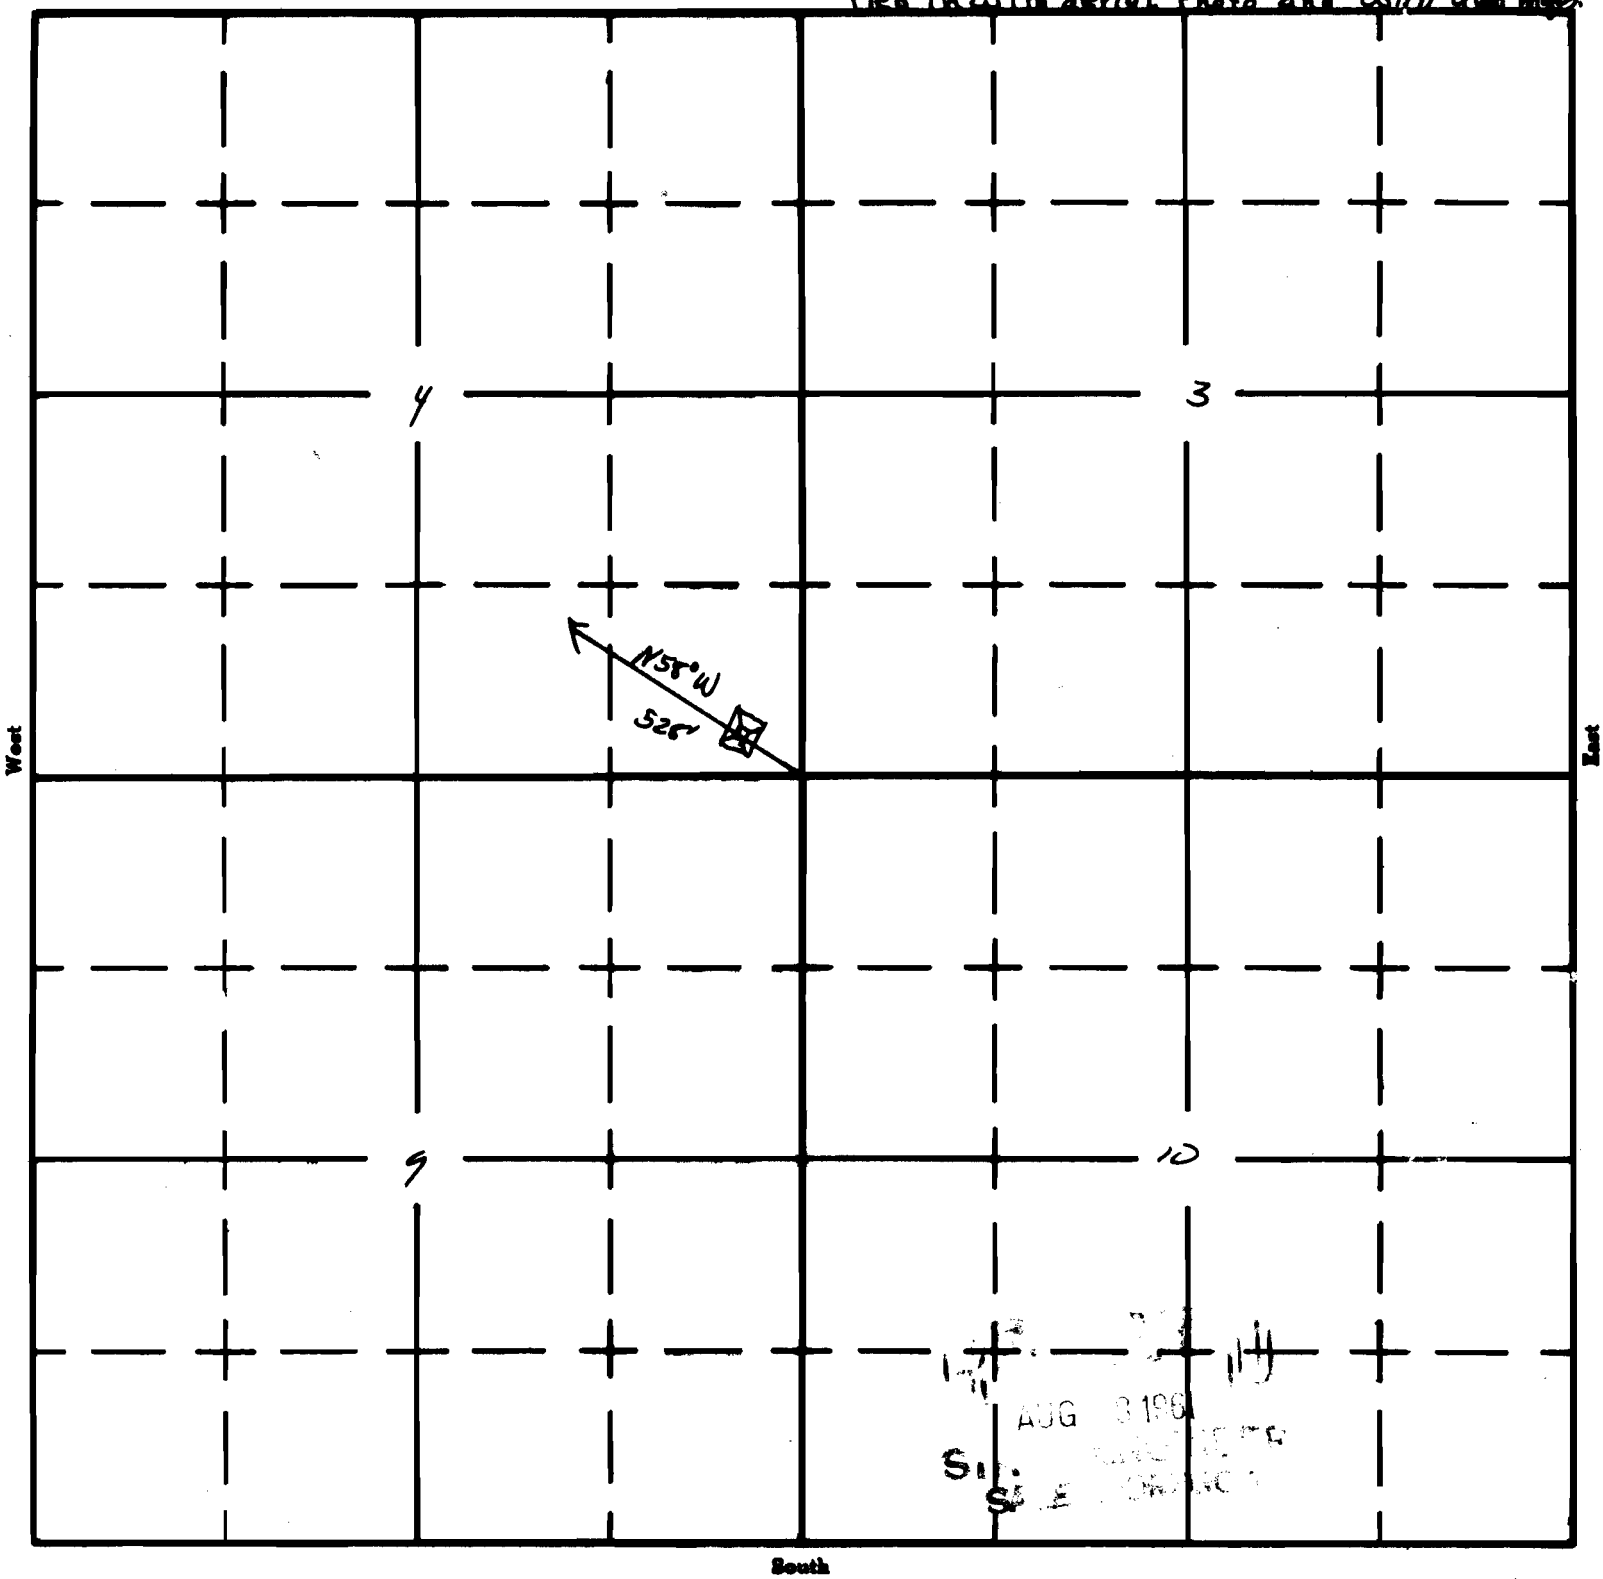

AUG 3 199

APPLICATION No. R-36434
PERMIT No. R 7162