

Form AI-187
March 1961

UNITED STATES
DEPARTMENT OF THE INTERIOR
BUREAU OF LAND MANAGEMENT

SECTION


13

SW 1/4 SE 1/4

Oregon State Water Filings

TOWNSHIP 35S, RANGE 22E, W. M.

North *Tied in with corner Photo and OS&O Quad Map.*

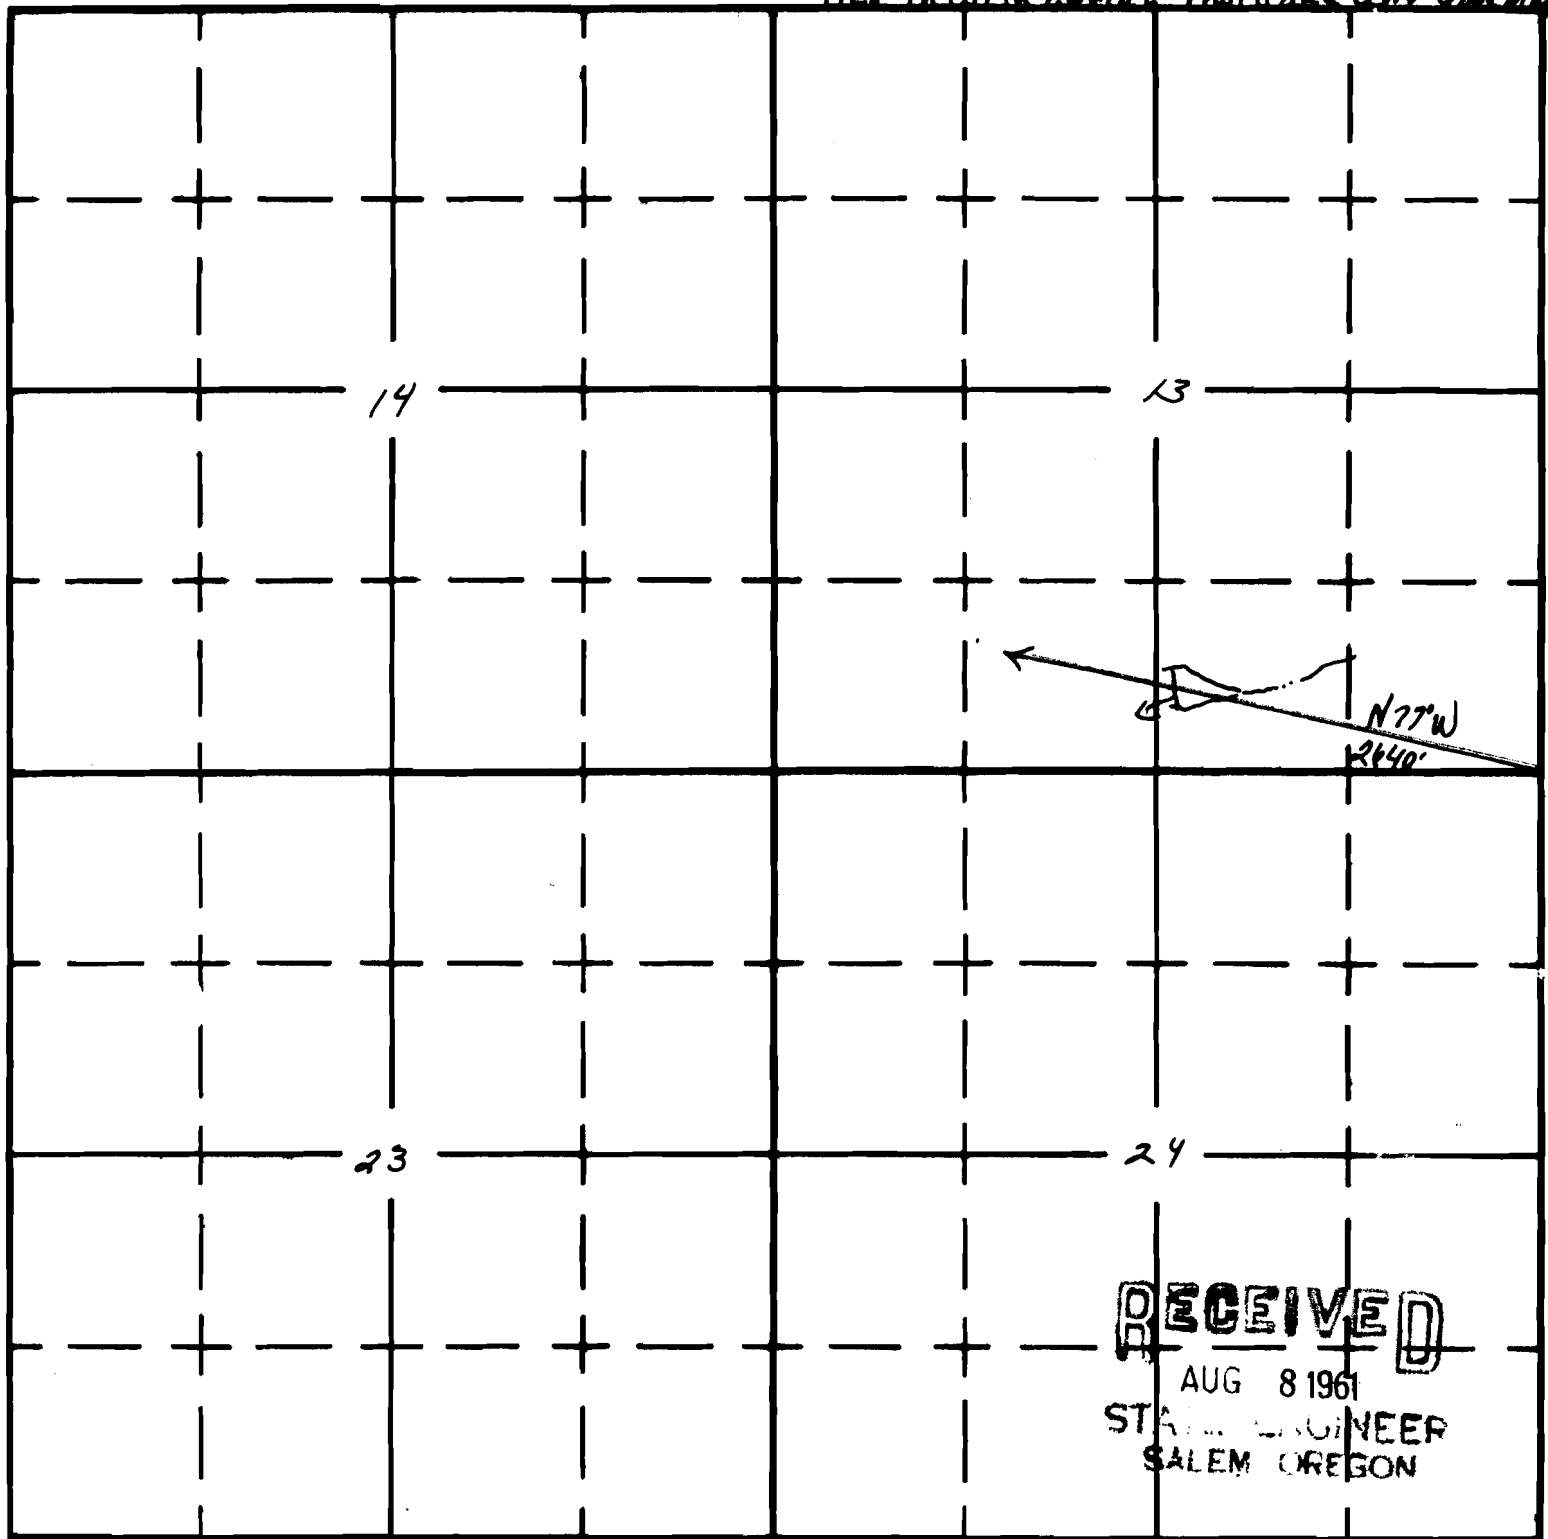

RECEIVED

AUG 8 1961

STATE ENGINEER
SALEM OREGON

APPLICATION No. R-36449
PERMIT No. R 7173