

Form AI-187
March 1961

UNITED STATES
DEPARTMENT OF THE INTERIOR
BUREAU OF LAND MANAGEMENT


SECTION 31

Oregon State Water Filings

SE 1/4 NW 1/4

TOWNSHIP 28s, RANGE 17E, W. M.

Tied in with aerial photos & O.S.N.D. Quad Maps

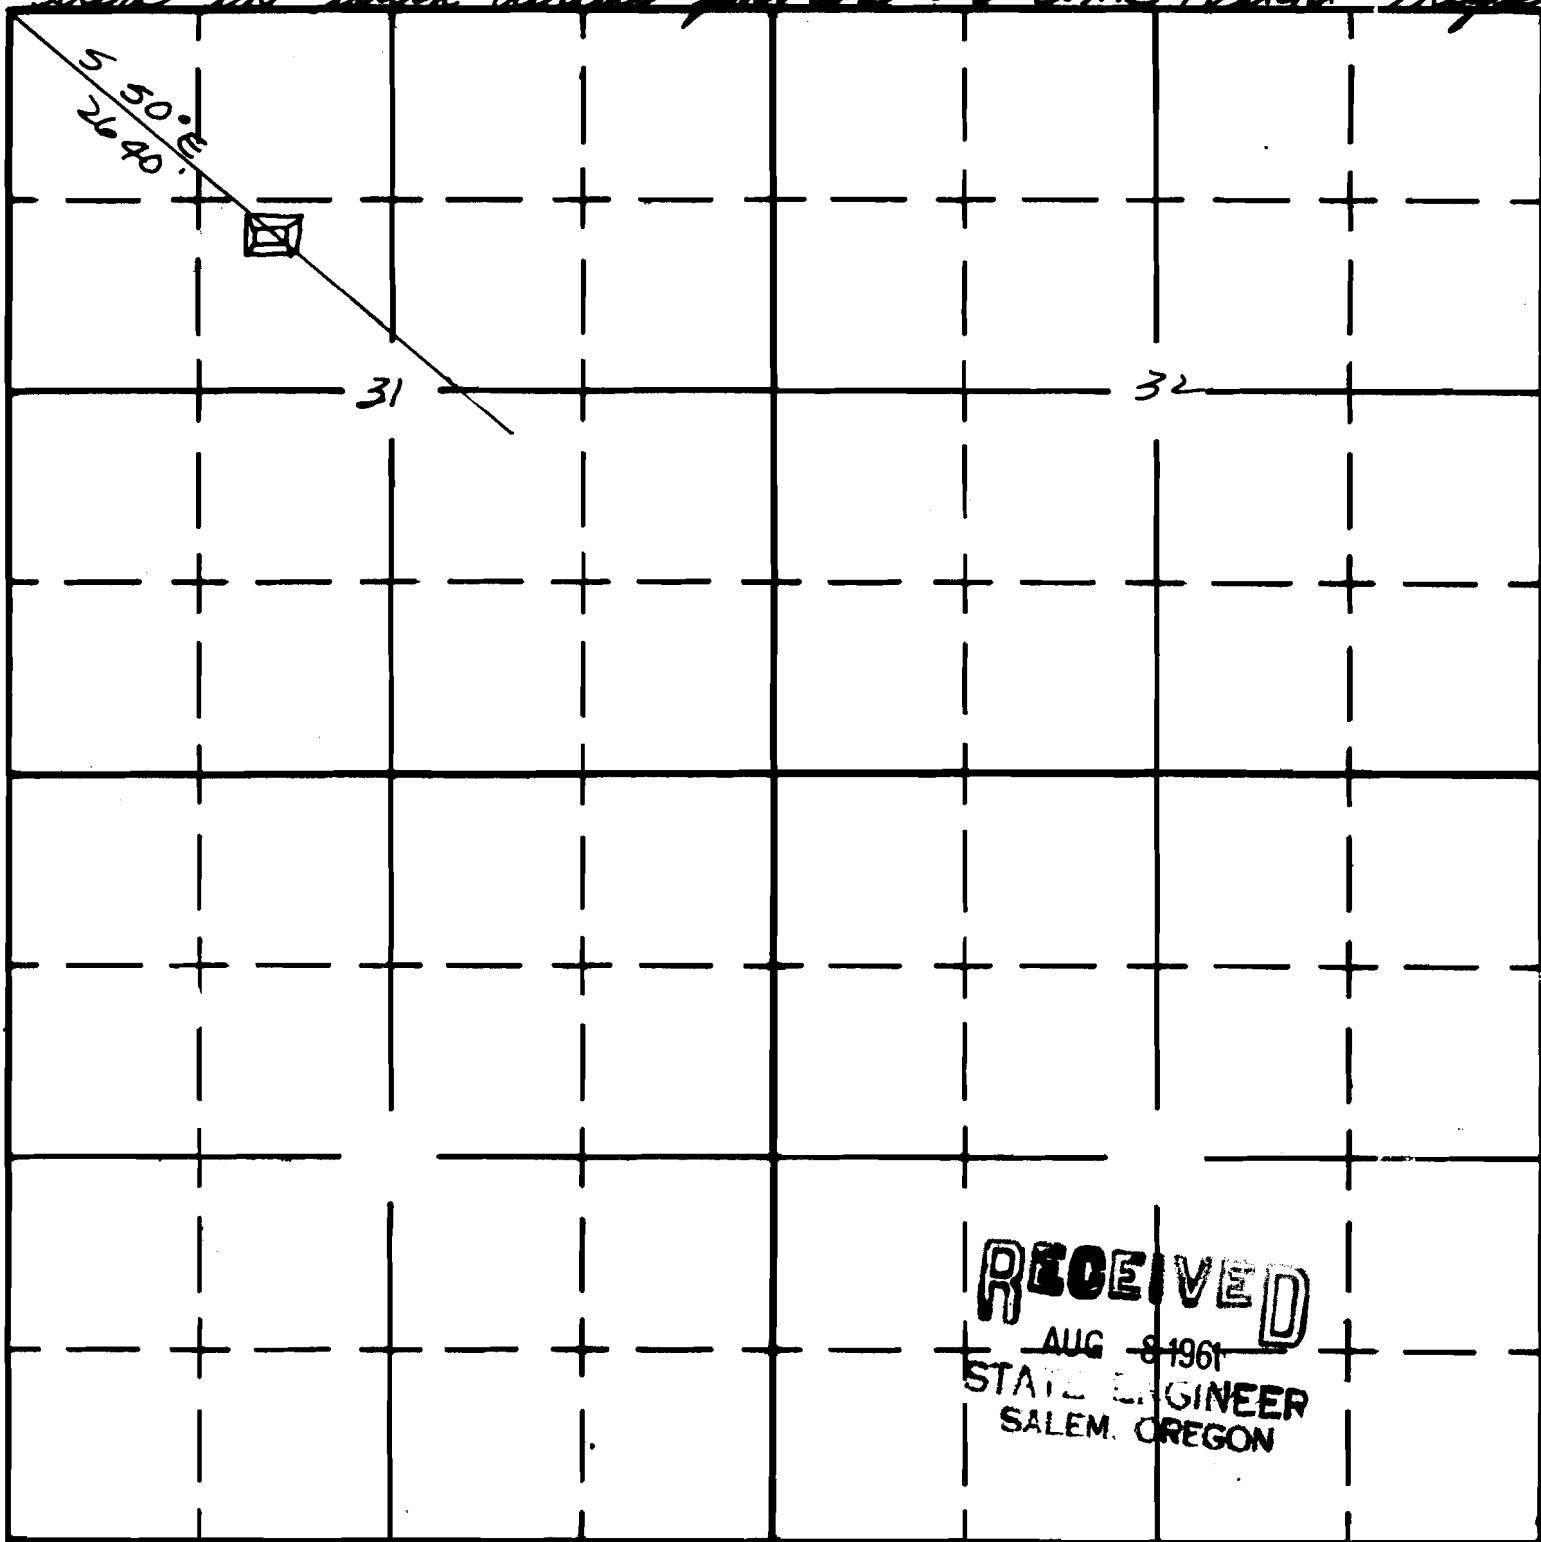

RECEIVED
AUG 8 1961
STATE ENGINEER
SALEM, OREGON

South

APPLICATION No. R-56478
PERMIT No. R 7189