

UNITED STATES
DEPARTMENT OF THE INTERIOR
BUREAU OF LAND MANAGEMENT

SECTION


4

Oregon State Water Filings

NW 1/4 SE 1/4

TOWNSHIP 29S, RANGE 17E, W. M.

Filed in with aerial photos & O.S.H.D. Quad Maps.

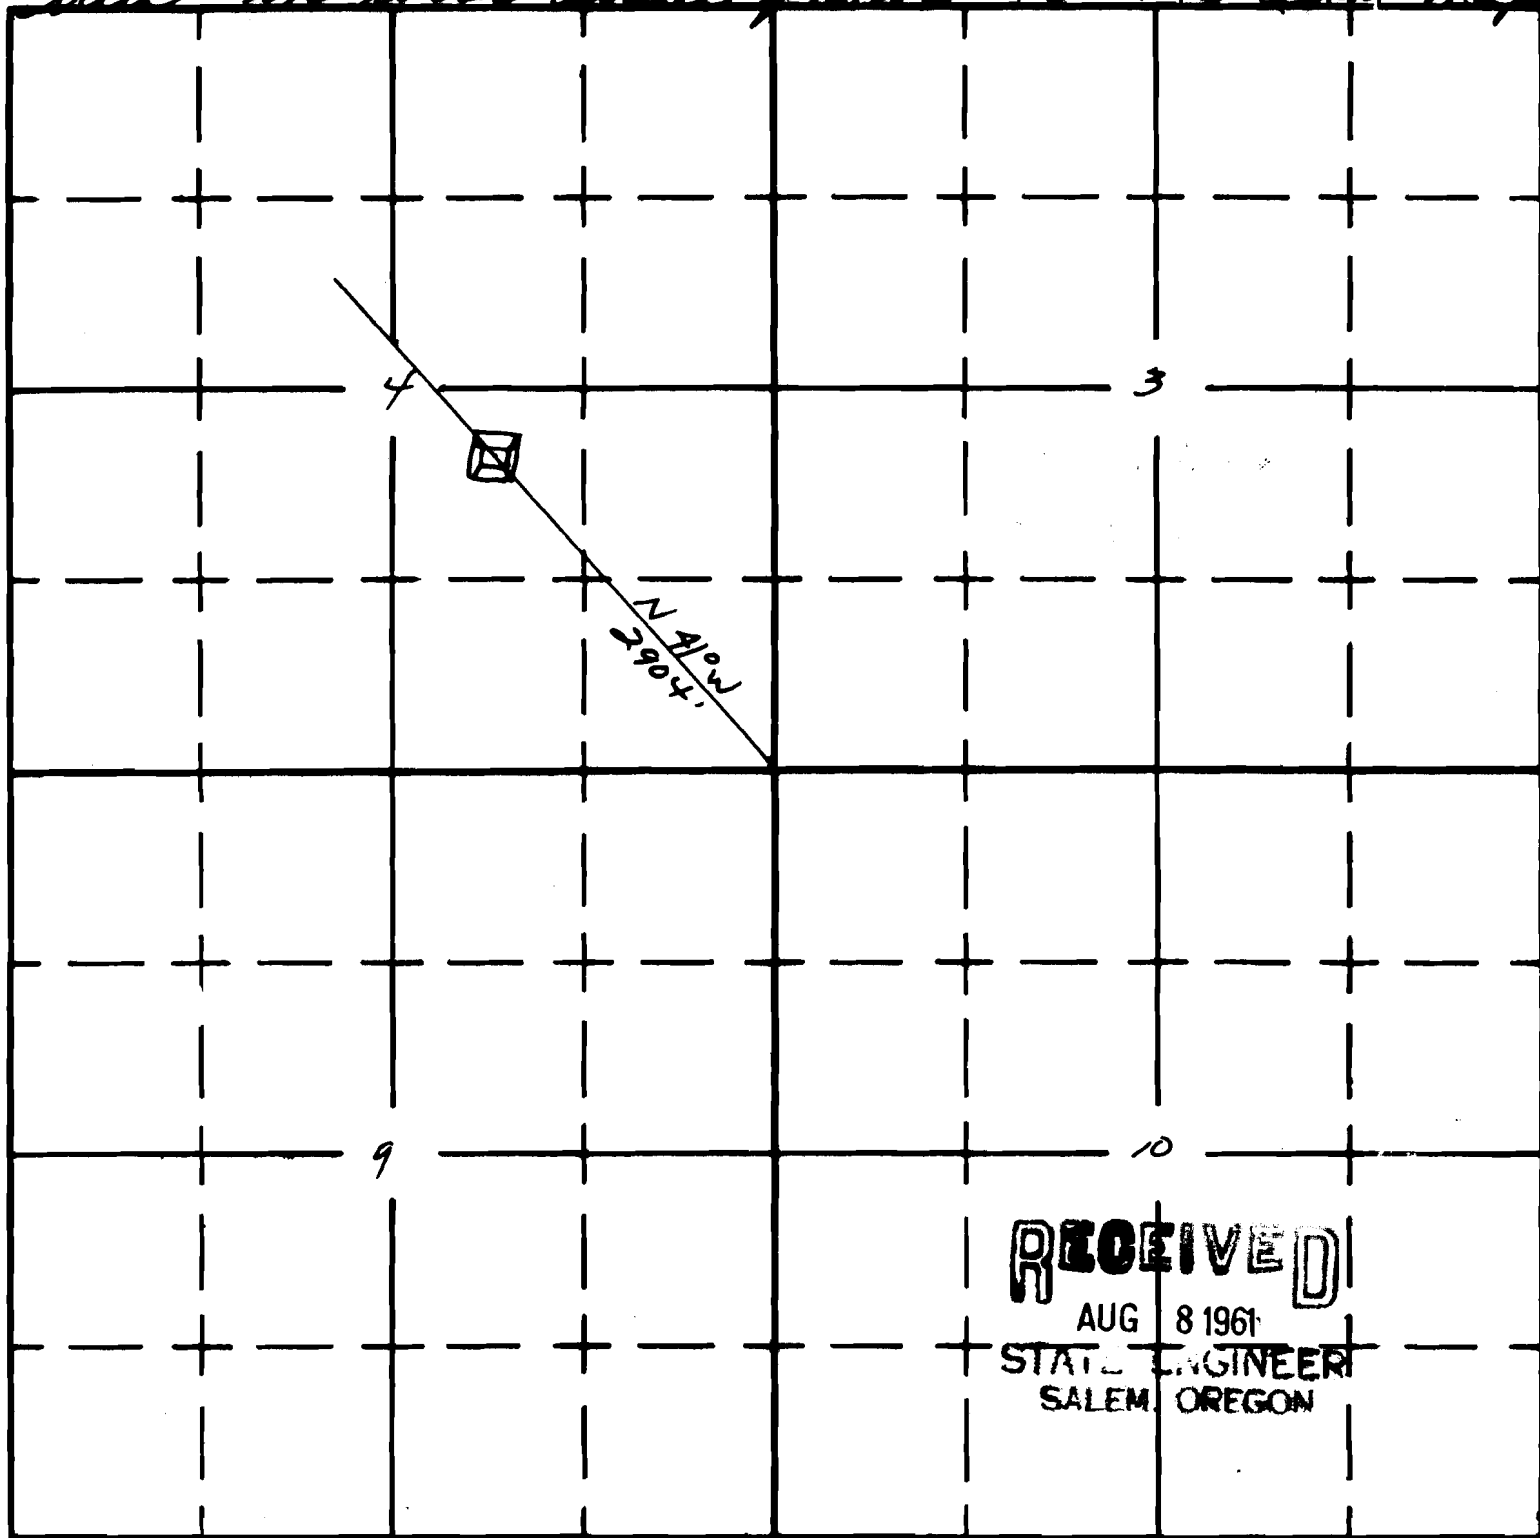

RECEIVED

AUG 8 1961

STATE ENGINEER
SALEM, OREGON