

Form AI-187
March 1961


UNITED STATES
DEPARTMENT OF THE INTERIOR
BUREAU OF LAND MANAGEMENT

SECTION 4

Oregon State Water Filings

SW 1/4 NW 1/4 TOWNSHIP 24 S, RANGE 17 E, W. M.

Tied in with aerial photos & O.S.H.D. Quad Maps.

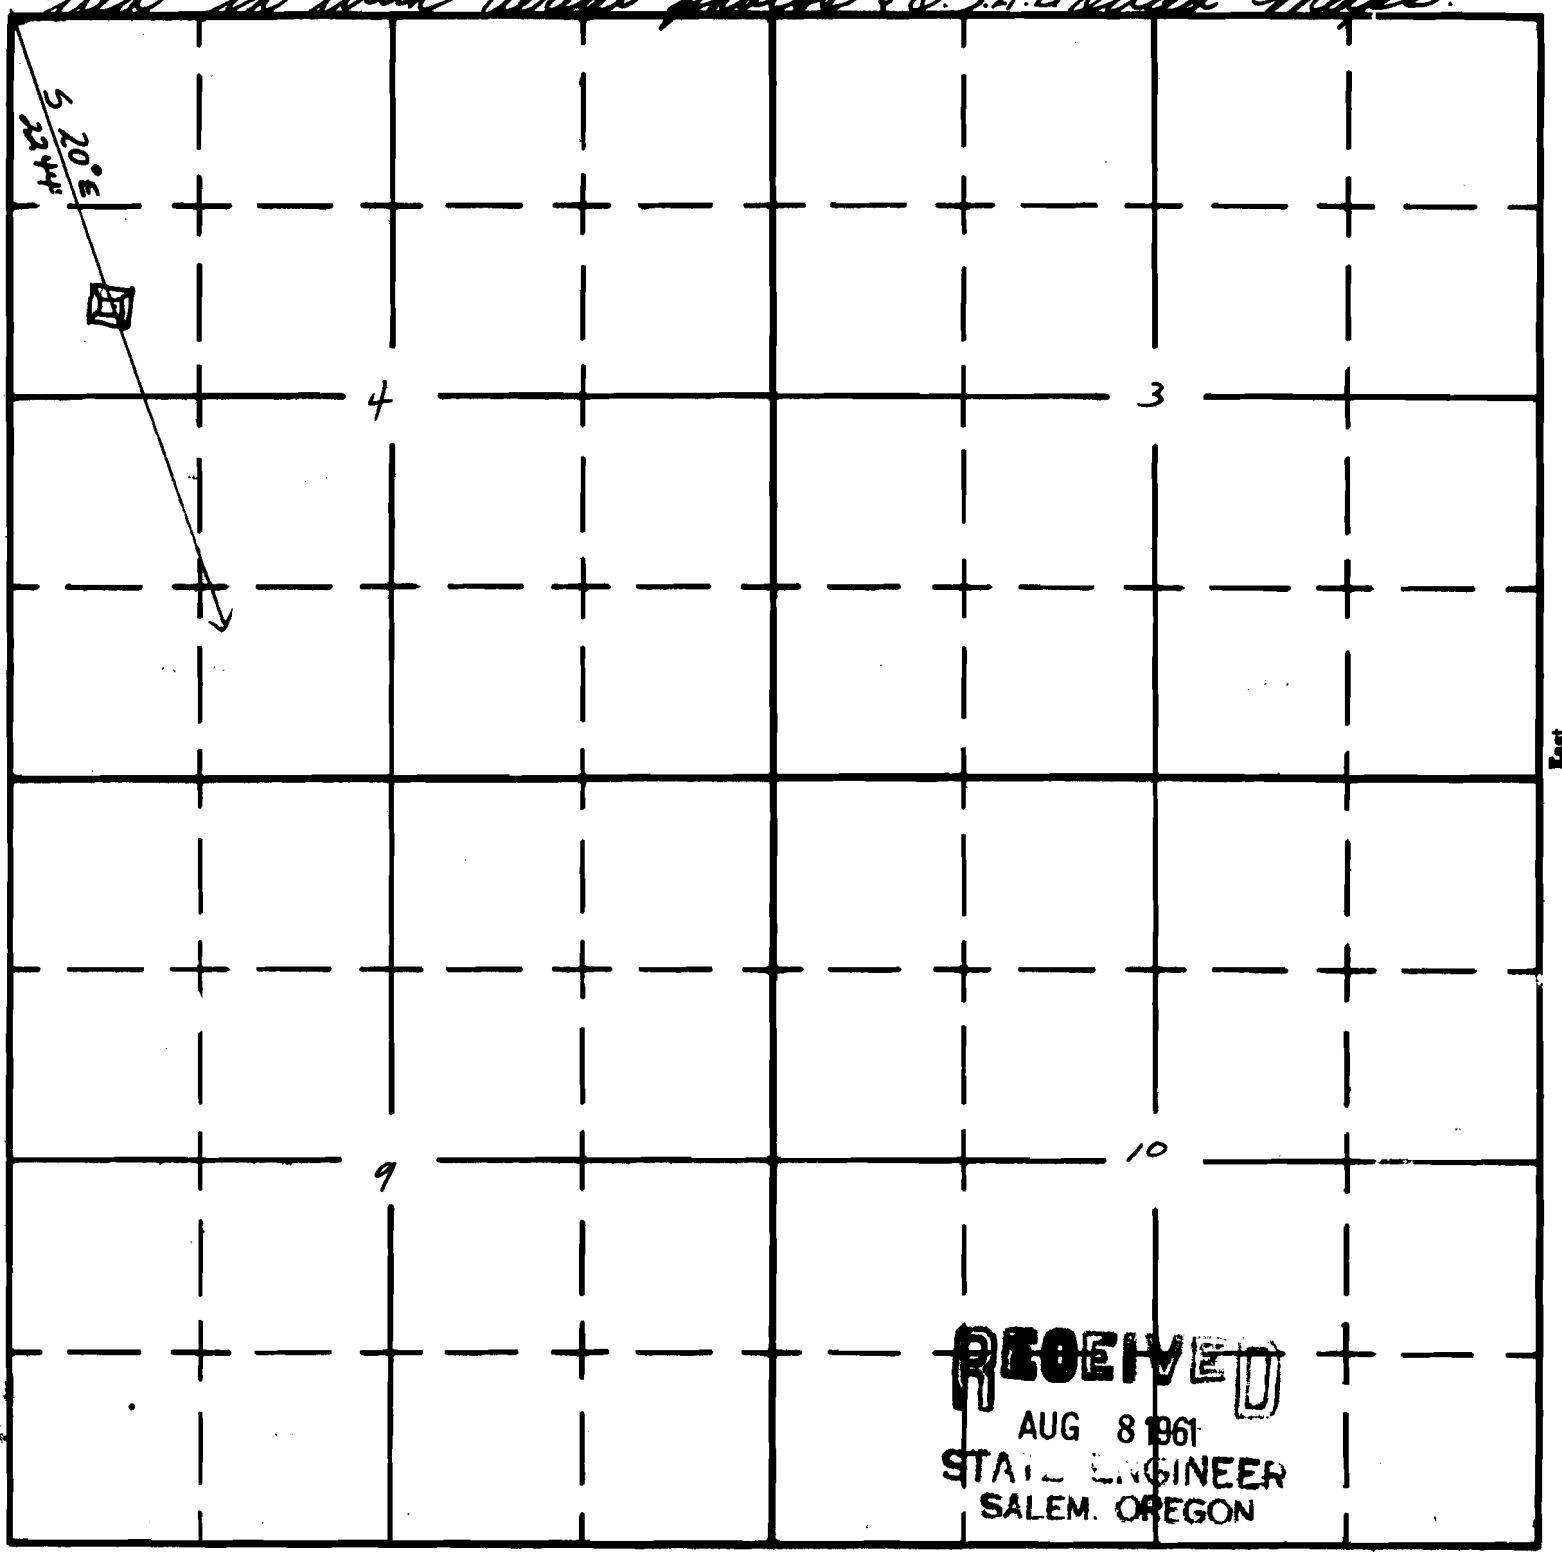

RECEIVED
AUG 8 1961
STATE ENGINEER
SALEM, OREGON

APPLICATION No. **R-36482**
PERMIT No. **R 7192**