

UNITED STATES
DEPARTMENT OF THE INTERIOR
BUREAU OF LAND MANAGEMENT

R-7196
78650


SECTION
20

Oregon State Water Filings

SW 1/4 SW 1/4

TOWNSHIP 32S, RANGE 20E, W. M.

Stud-in with aerial photos North: O.S.H.P. Quad Maps.

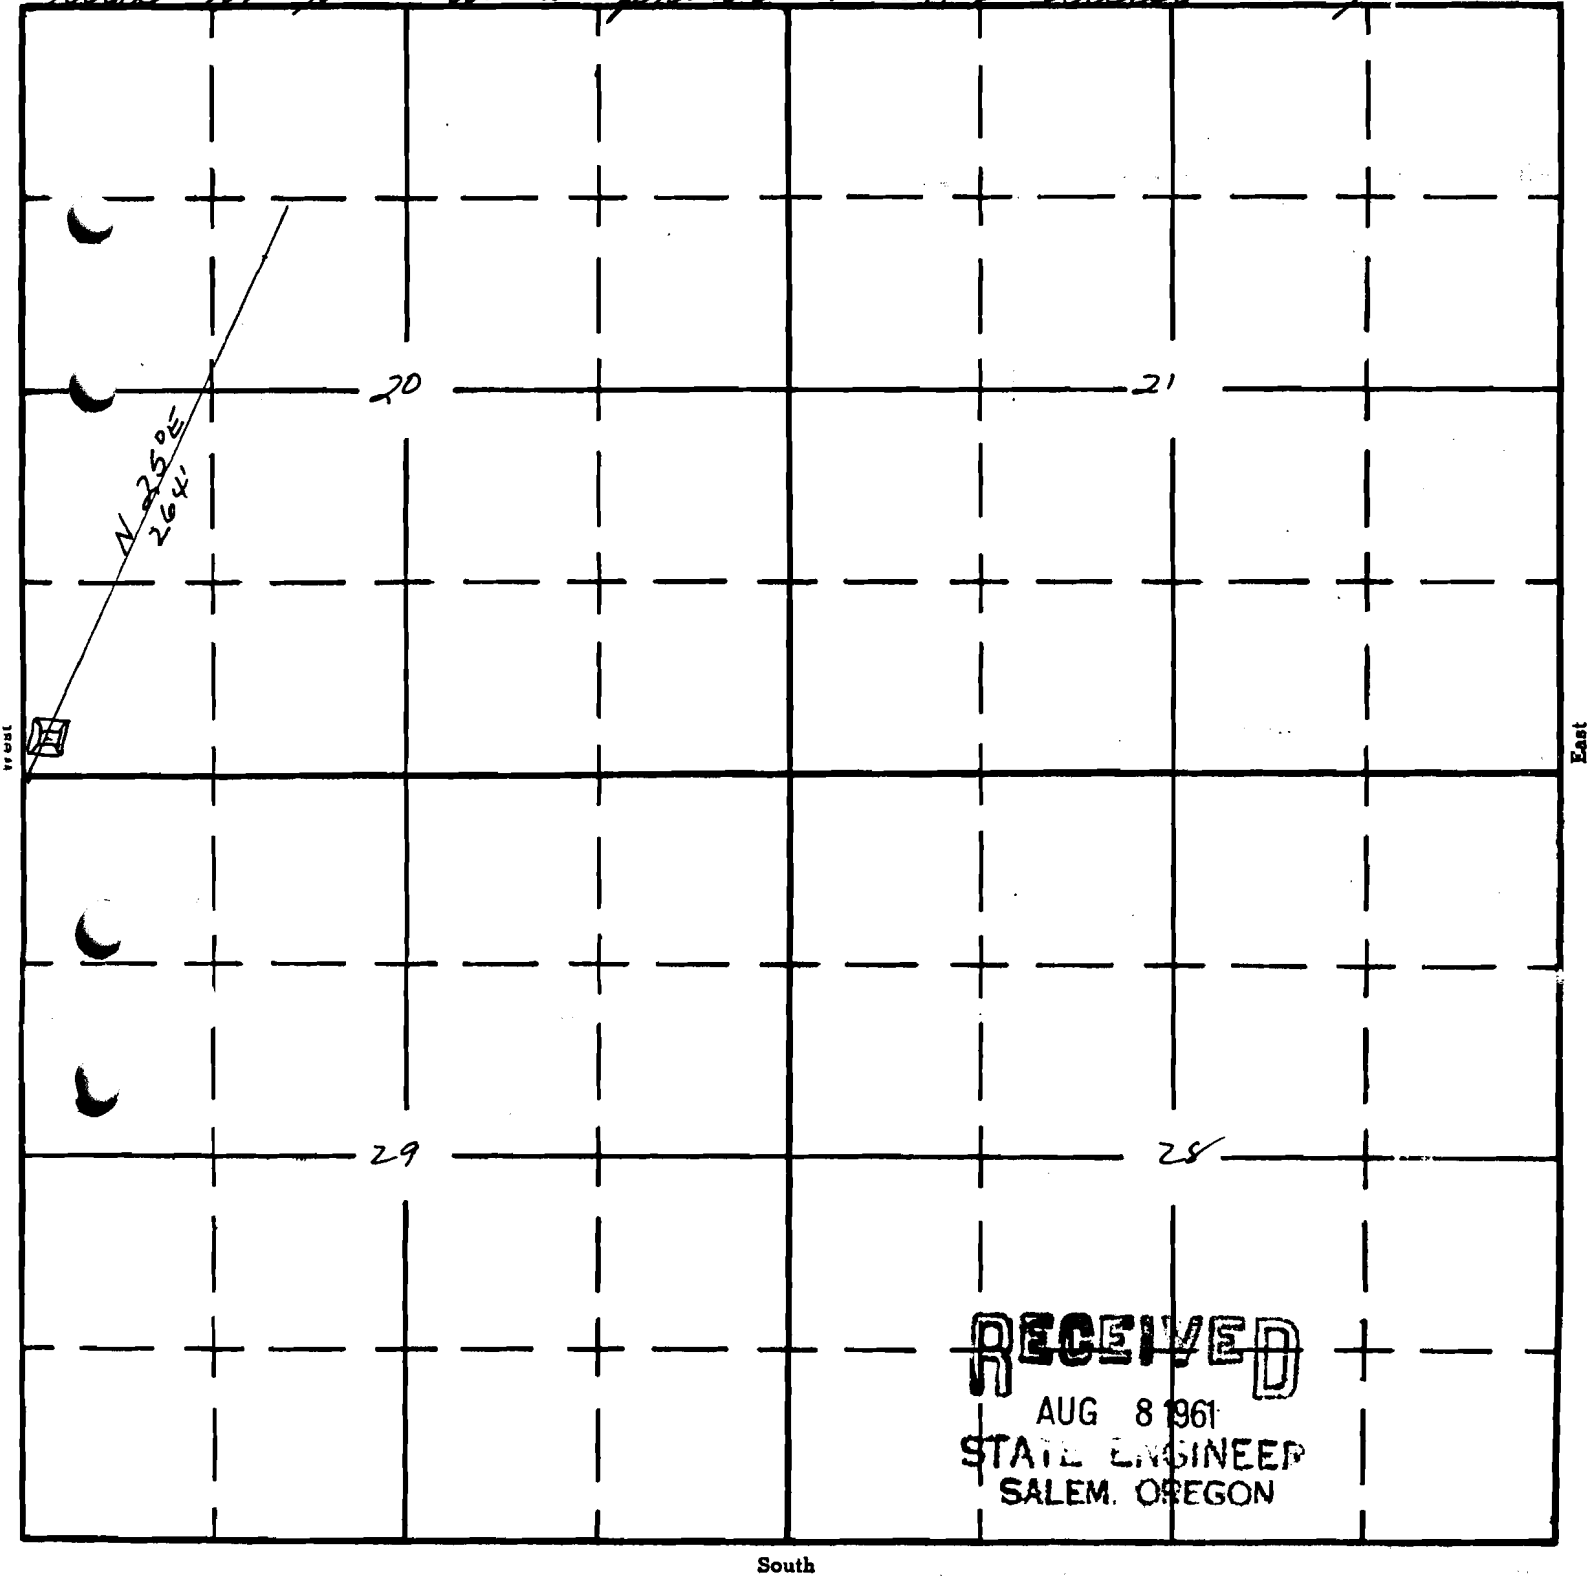

RECEIVED
AUG 8 1961
STATE ENGINEER
SALEM, OREGON

APPLICATION No. R-36487
PERMIT No. R 7196

APPLICATION No. **R-36487**
PERMIT No. **R 7196**