

R-7200

78653

Form AI-187
March 1961

UNITED STATES
DEPARTMENT OF THE INTERIOR
BUREAU OF LAND MANAGEMENT


SECTION 30

Oregon State Water Filings

NE 1/4 SW 1/4

TOWNSHIP 29S, RANGE 20E, W. M.

Tied-in with aerial photos & D.S.H.D. Quad Maps.

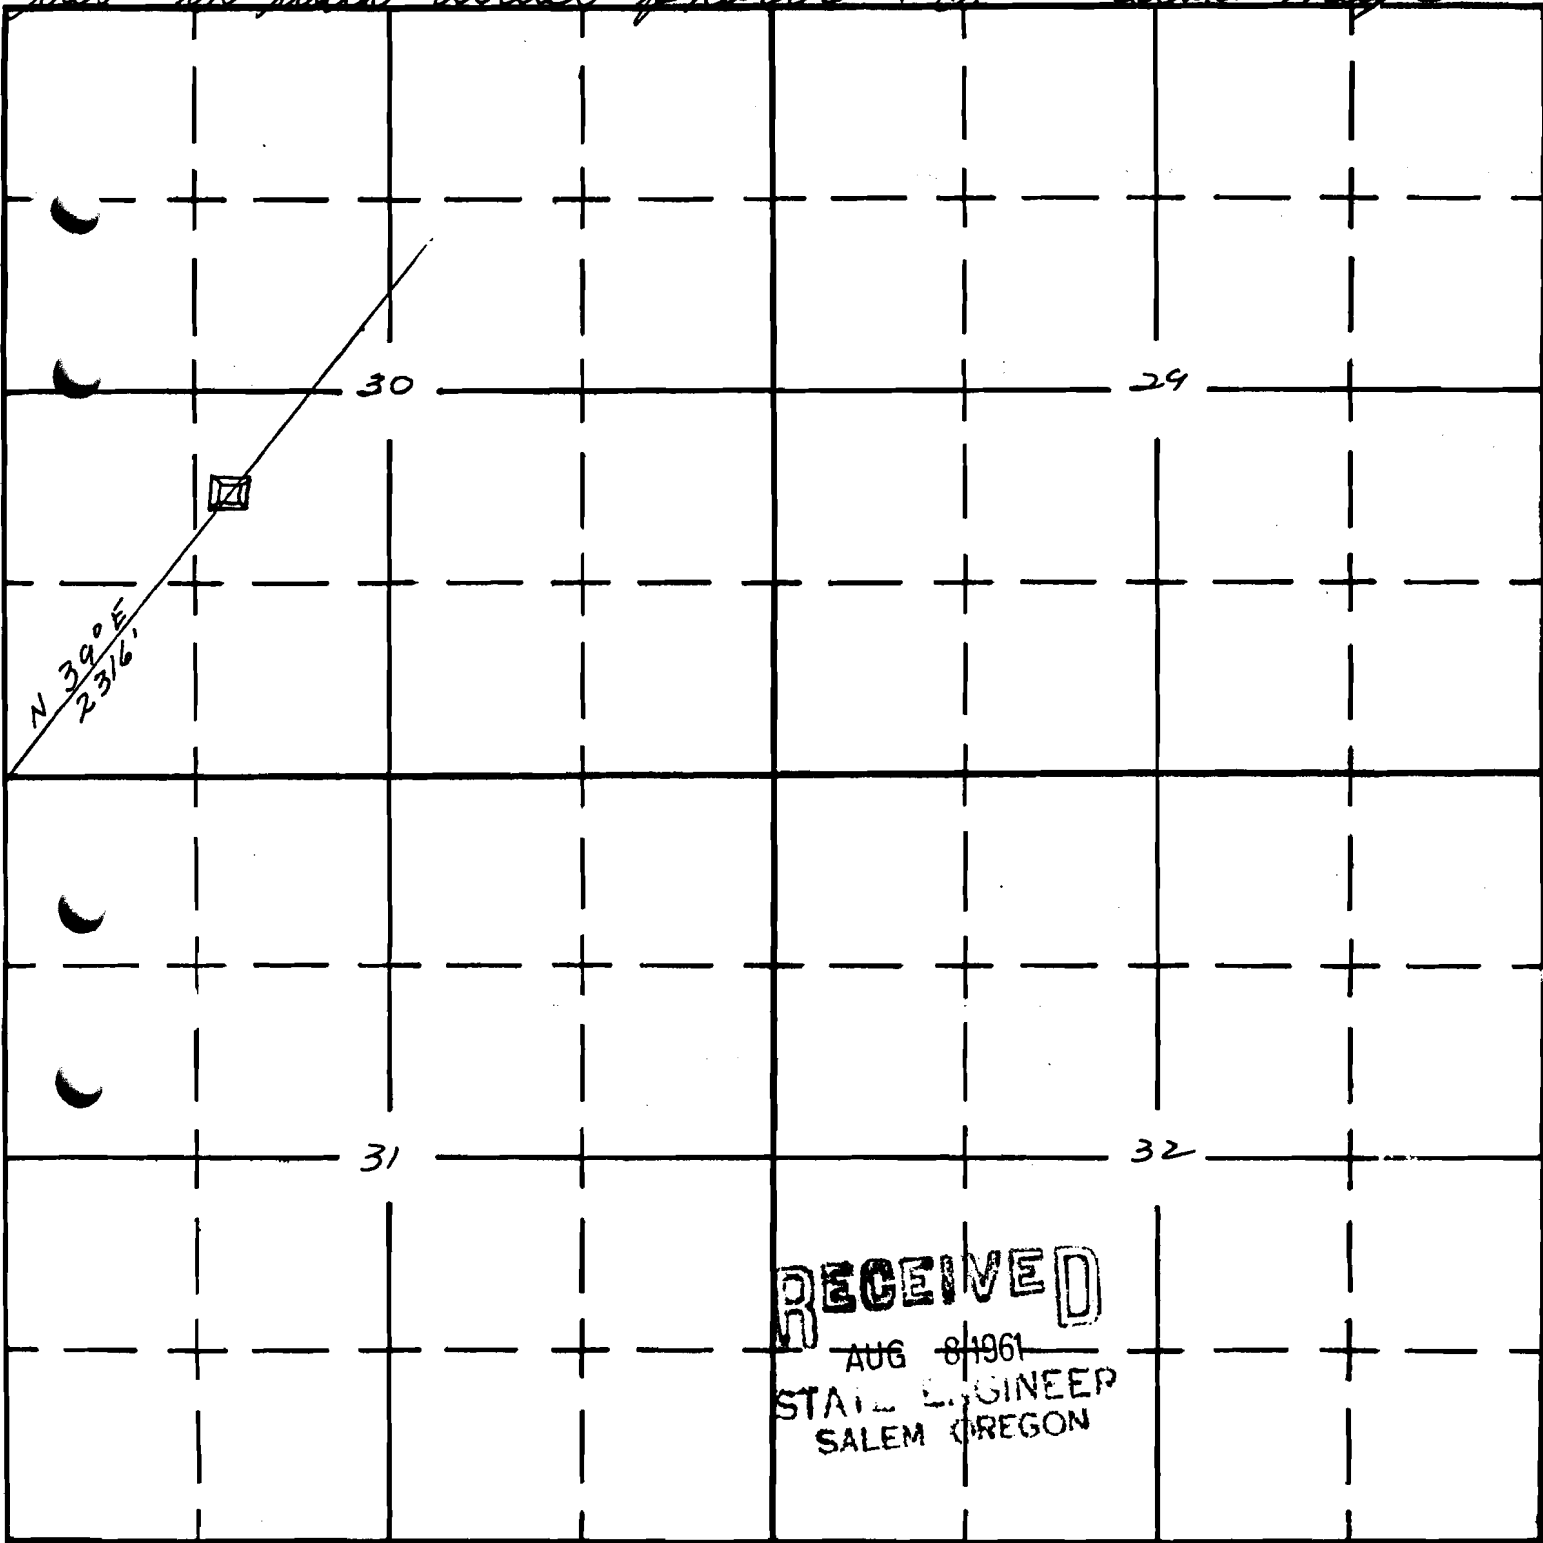

RECEIVED
AUG 8 1961
STATE ENGINEER
SALEM OREGON

South

APPLICATION No. R-36491
PERMIT No. R 7200

Form AI-187
March 1961

UNITED STATES
DEPARTMENT OF THE INTERIOR
BUREAU OF LAND MANAGEMENT

SECTION


30

Oregon State Water Filings

NE 1/4 SW 1/4

TOWNSHIP 29S, RANGE 20E, W. M.

Tied-in with aerial photos & D.S.D. Quad Maps.

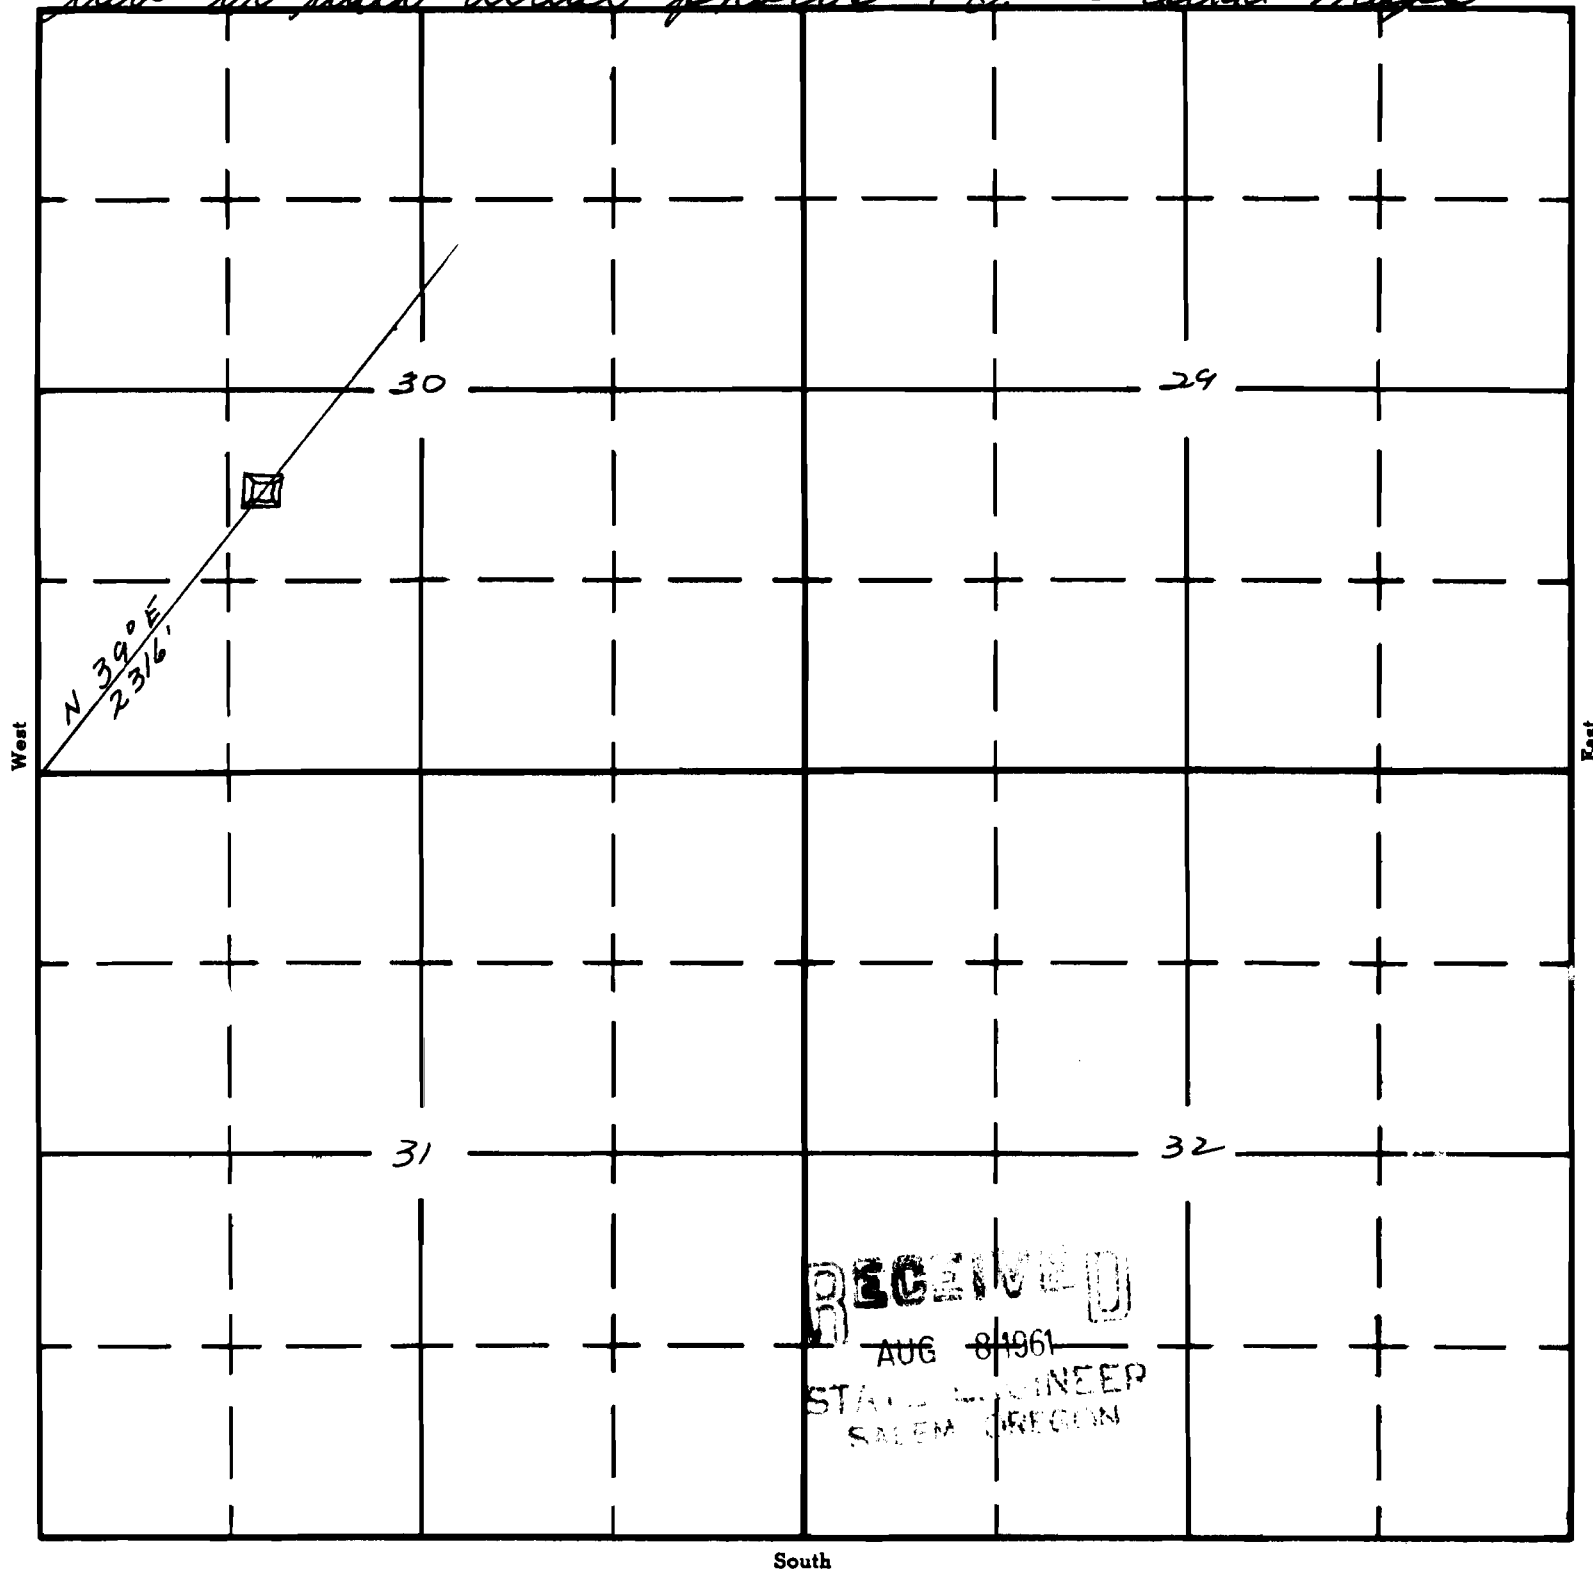

APPLICATION No. R-36491
PERMIT No. R 7200