

UNITED STATES
DEPARTMENT OF THE INTERIOR
BUREAU OF LAND MANAGEMENT

SECTION


32

Oregon State Water Filings

NW 1/4 SW 1/4

TOWNSHIP 29S, RANGE 20E, W. M.

Tied in with aerial photos: O.S.H.D. Quad Maps.

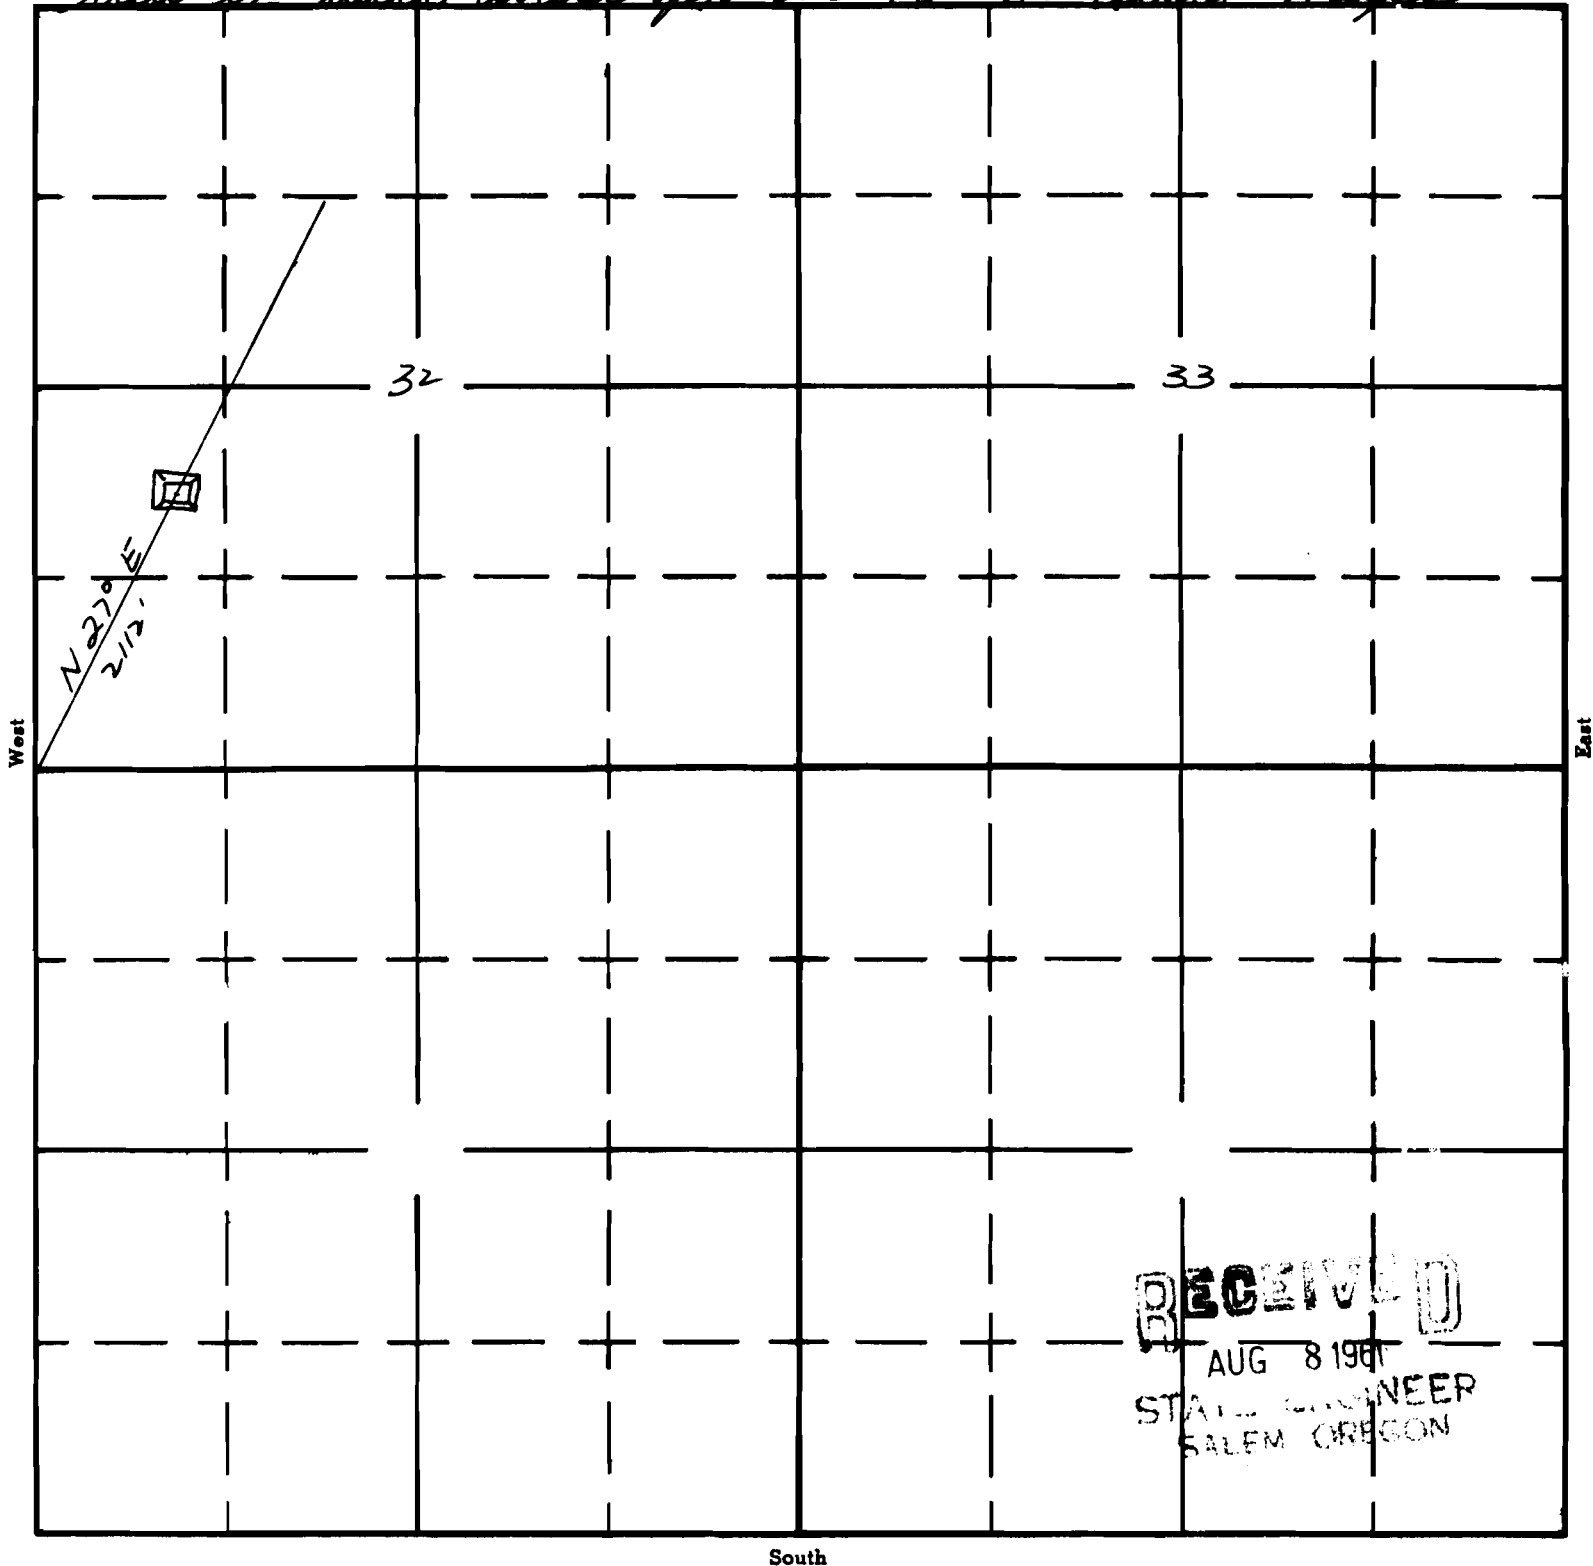

APPLICATION No. R-36492
PERMIT No. R 7201