


SECTION


13

Oregon State Water Filings

SW¹/₄ SW¹/₄

TOWNSHIP 31S, RANGE 20E, W. M.

Tied in with aerial photos & O.S.H.D. Quad Maps.

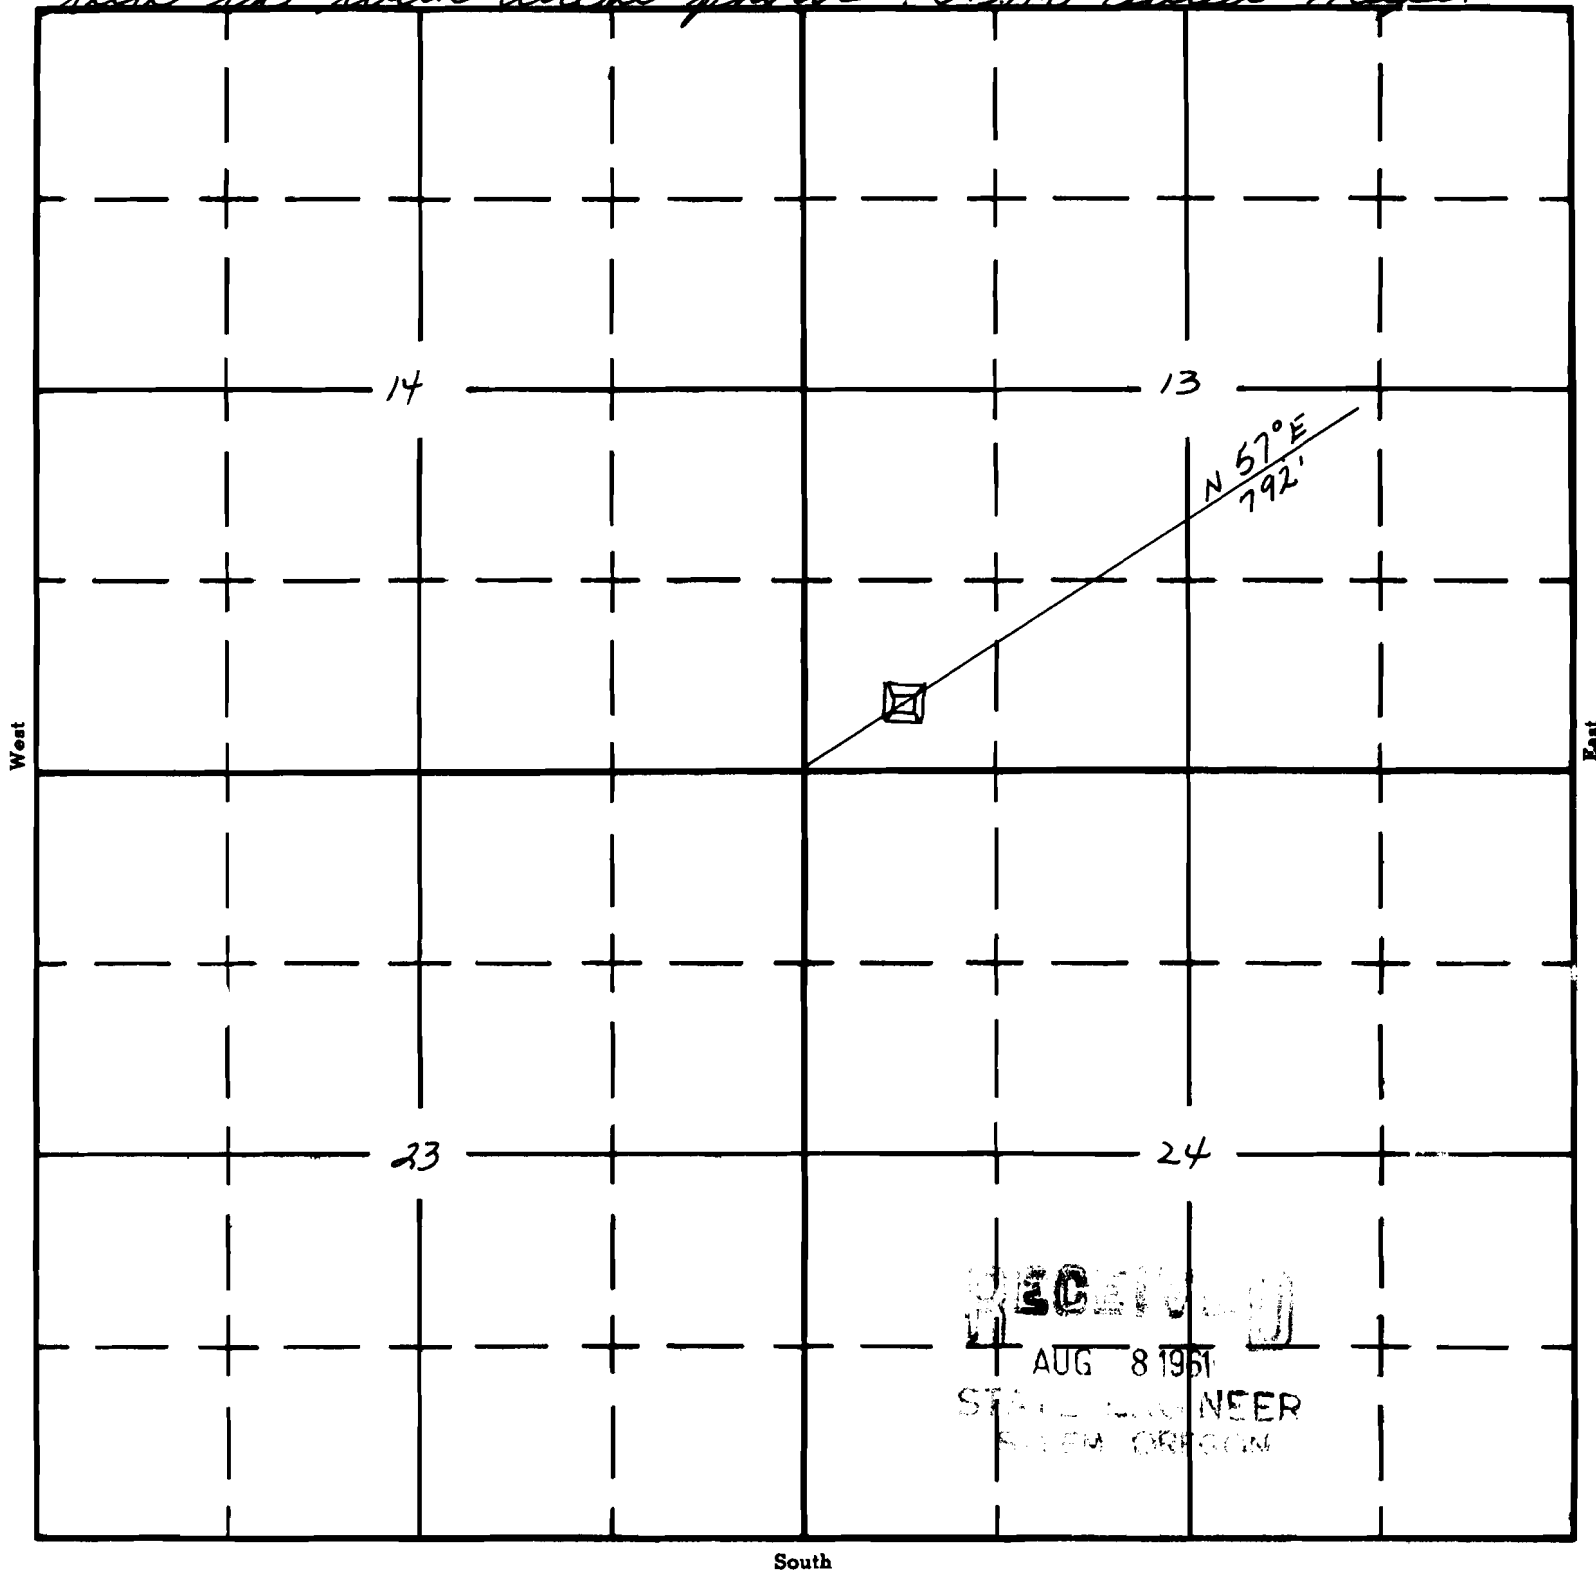

APPLICATION No. R-3649
PERMIT No. R 7203