

UNITED STATES
DEPARTMENT OF THE INTERIOR
BUREAU OF LAND MANAGEMENT


SECTION 23

Oregon State Water Filings

SW 1/4 SW 1/4

TOWNSHIP 29S, RANGE 16E, W. M.

TIED - IN WITH AERIAL PHOTO^{North} AND U.S.H.D. QUAD MAPS

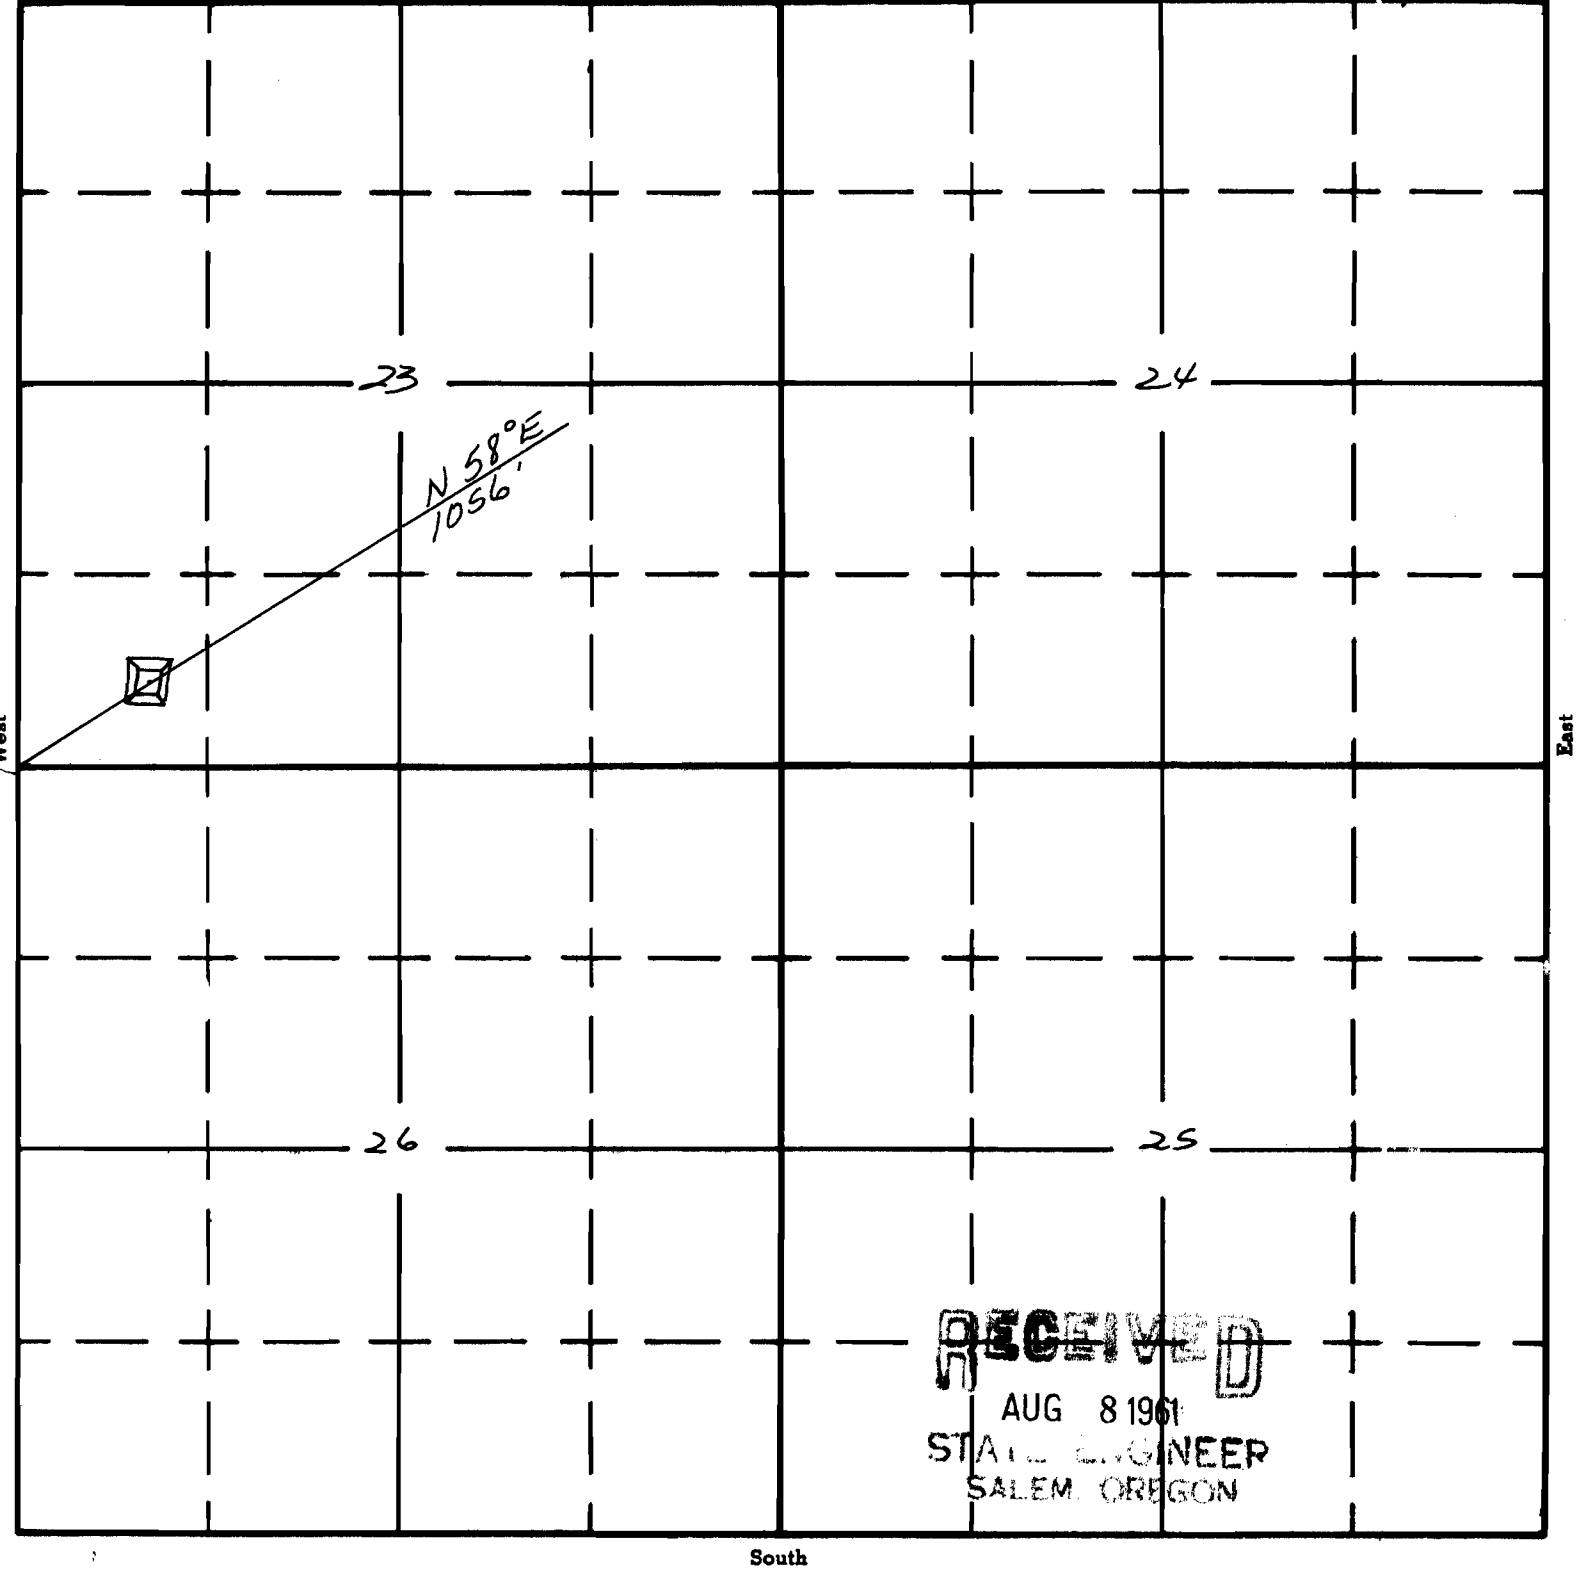

RECEIVED
AUG 8 1961
STATE ENGINEER
SALEM, OREGON