

Form A1-187
March 1961


UNITED STATES
DEPARTMENT OF THE INTERIOR
BUREAU OF LAND MANAGEMENT

SECTION 26

Oregon State Water Filings

SE 1/4 NW 1/4 TOWNSHIP 26S, RANGE 21E, W. M.

Filed - in with aerial ^{North} photos & O.S.H.D. Quad Maps.

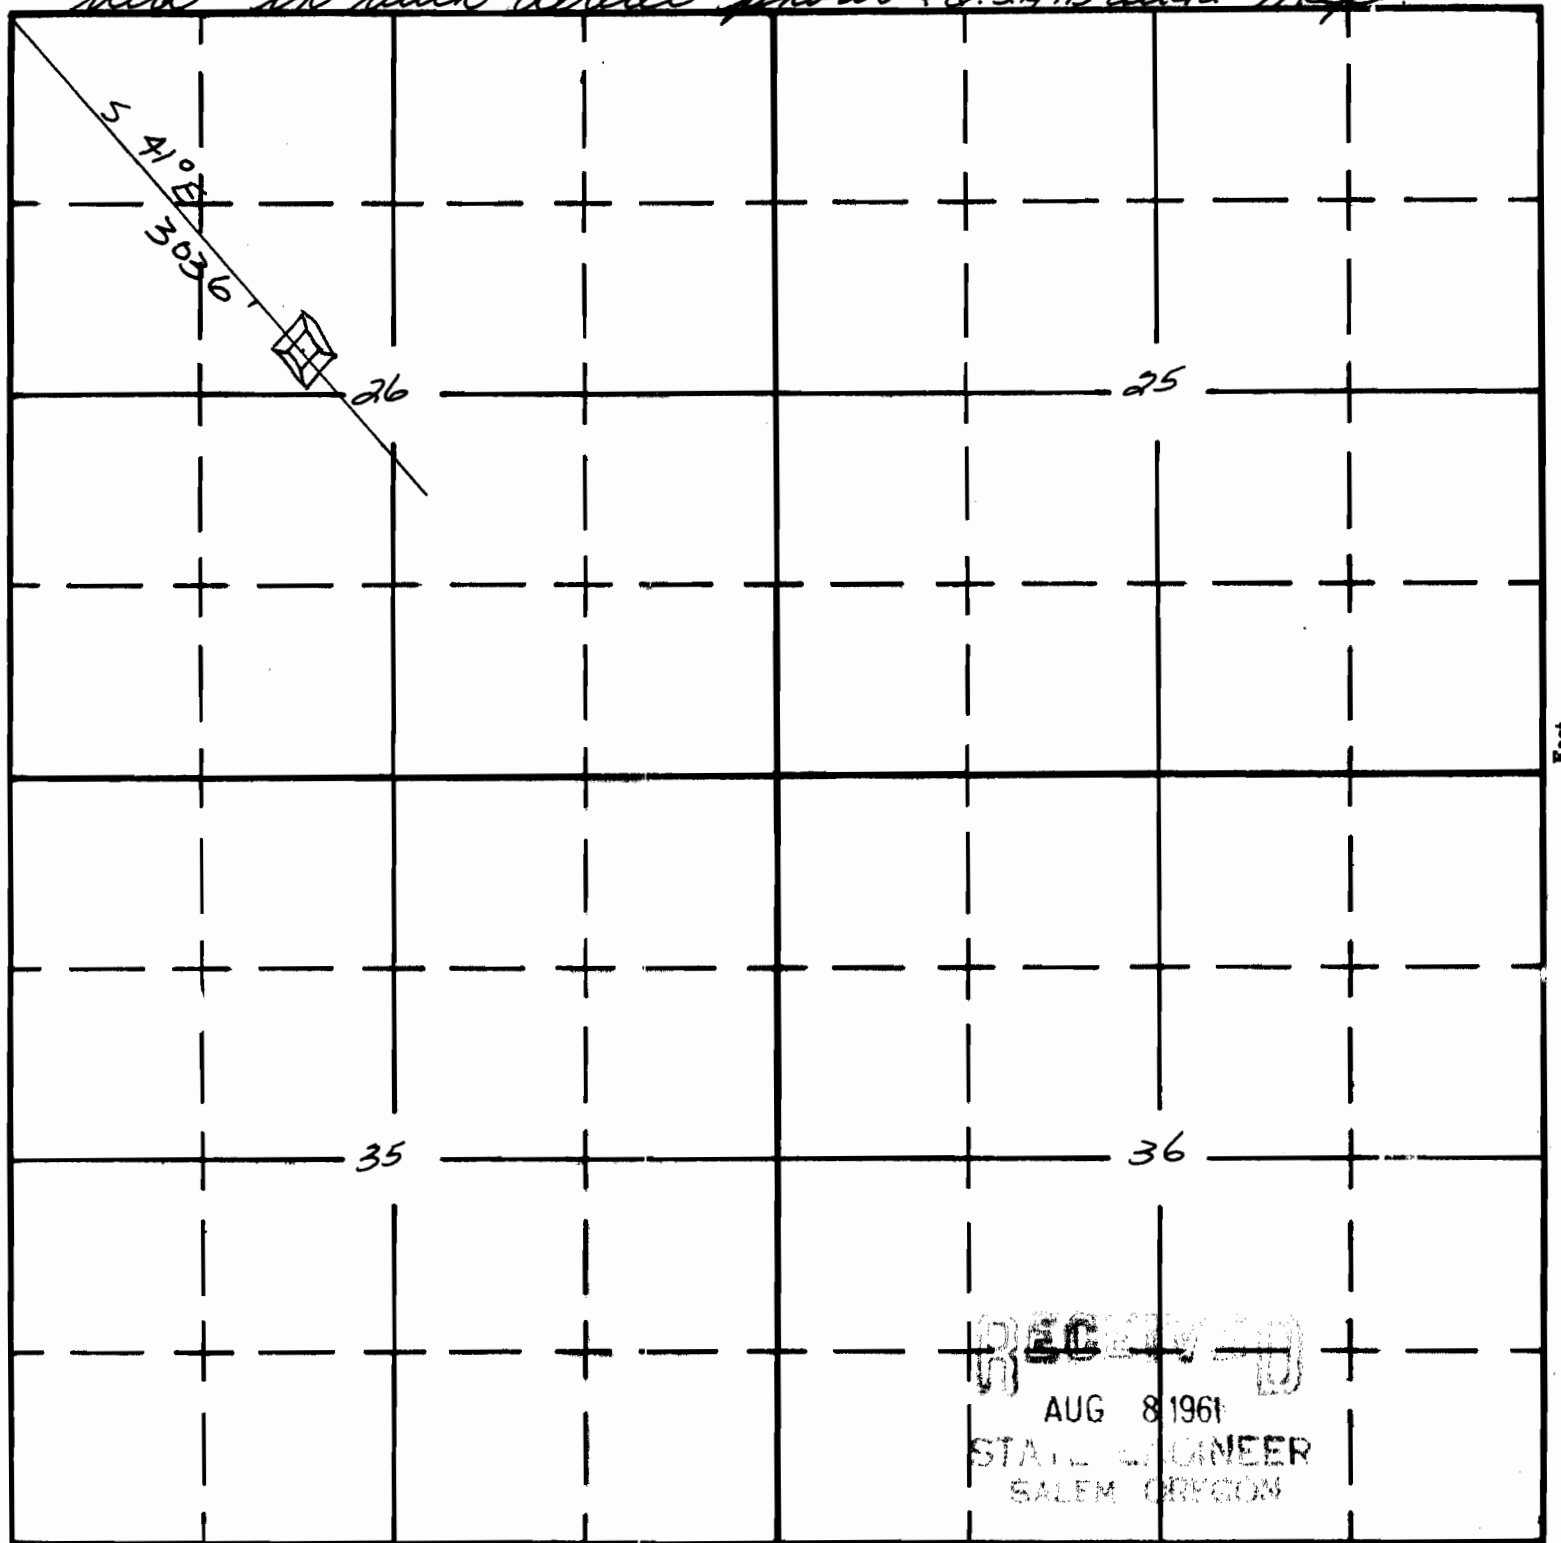

RECEIVED
AUG 8 1961
STATE ENGINEER
SALEM OREGON

APPLICATION No. R-36507
PERMIT No. R 7215