

Form A1-187
March 1961

UNITED STATES
DEPARTMENT OF THE INTERIOR
BUREAU OF LAND MANAGEMENT

SECTION


15

SE 1/4 NE 1/4

Oregon State Water Filings

TOWNSHIP 23 S, RANGE 18 E, W. M.

North *Tied in with aerial photo and OSHD Quad Map.*

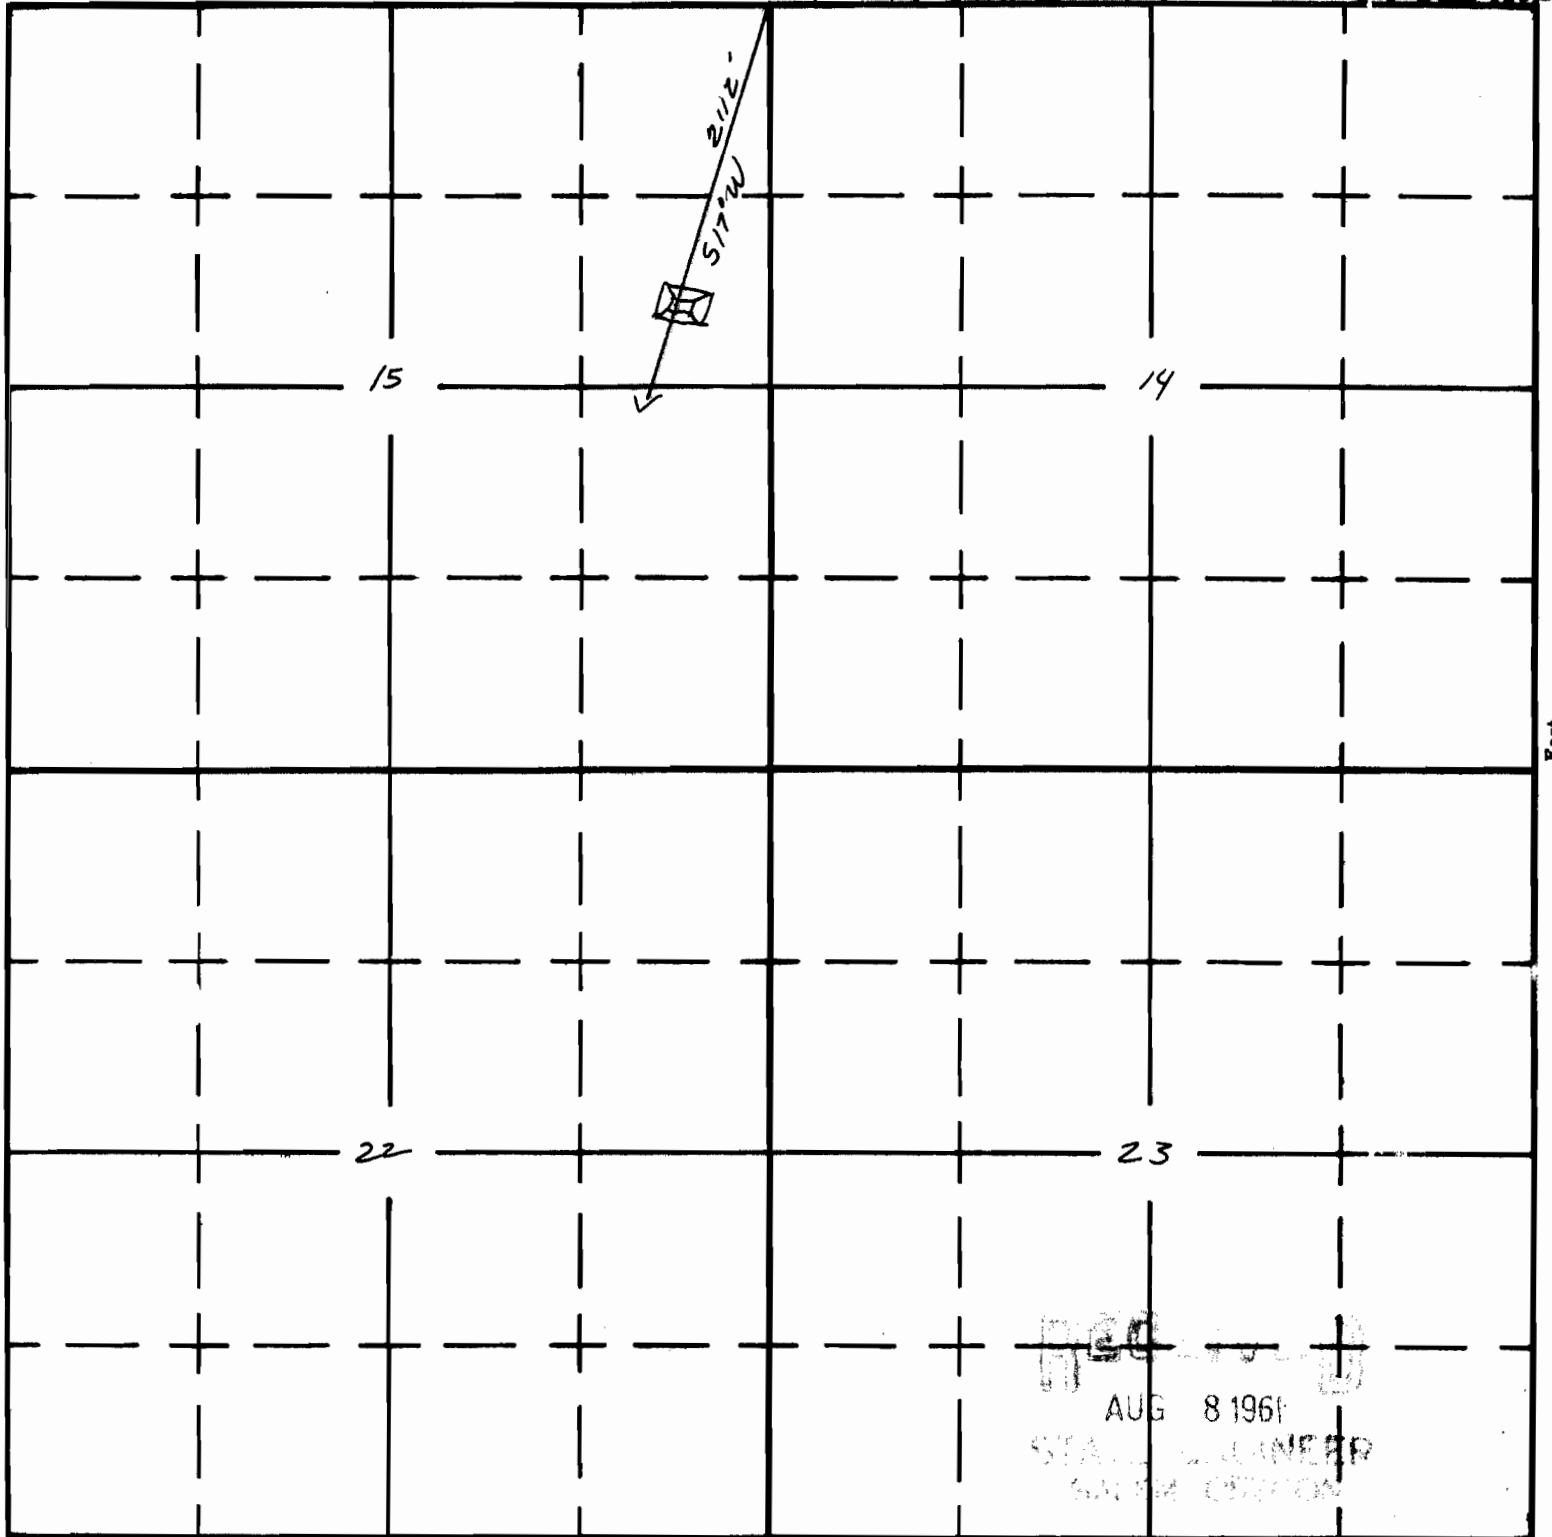

REC-10-10
AUG 8 1961
STATE ENGINEER

South

APPLICATION No. R-36528

PERMIT No. R 7222