

Form AI-187
March 1961

UNITED STATES
DEPARTMENT OF THE INTERIOR
BUREAU OF LAND MANAGEMENT

SECTION


10

NW 1/4 SW 1/4

Oregon State Water Filings

TOWNSHIP 29S, RANGE 17E, W. M.

North Tied in with aerial Photo and OS&D Quad Maps

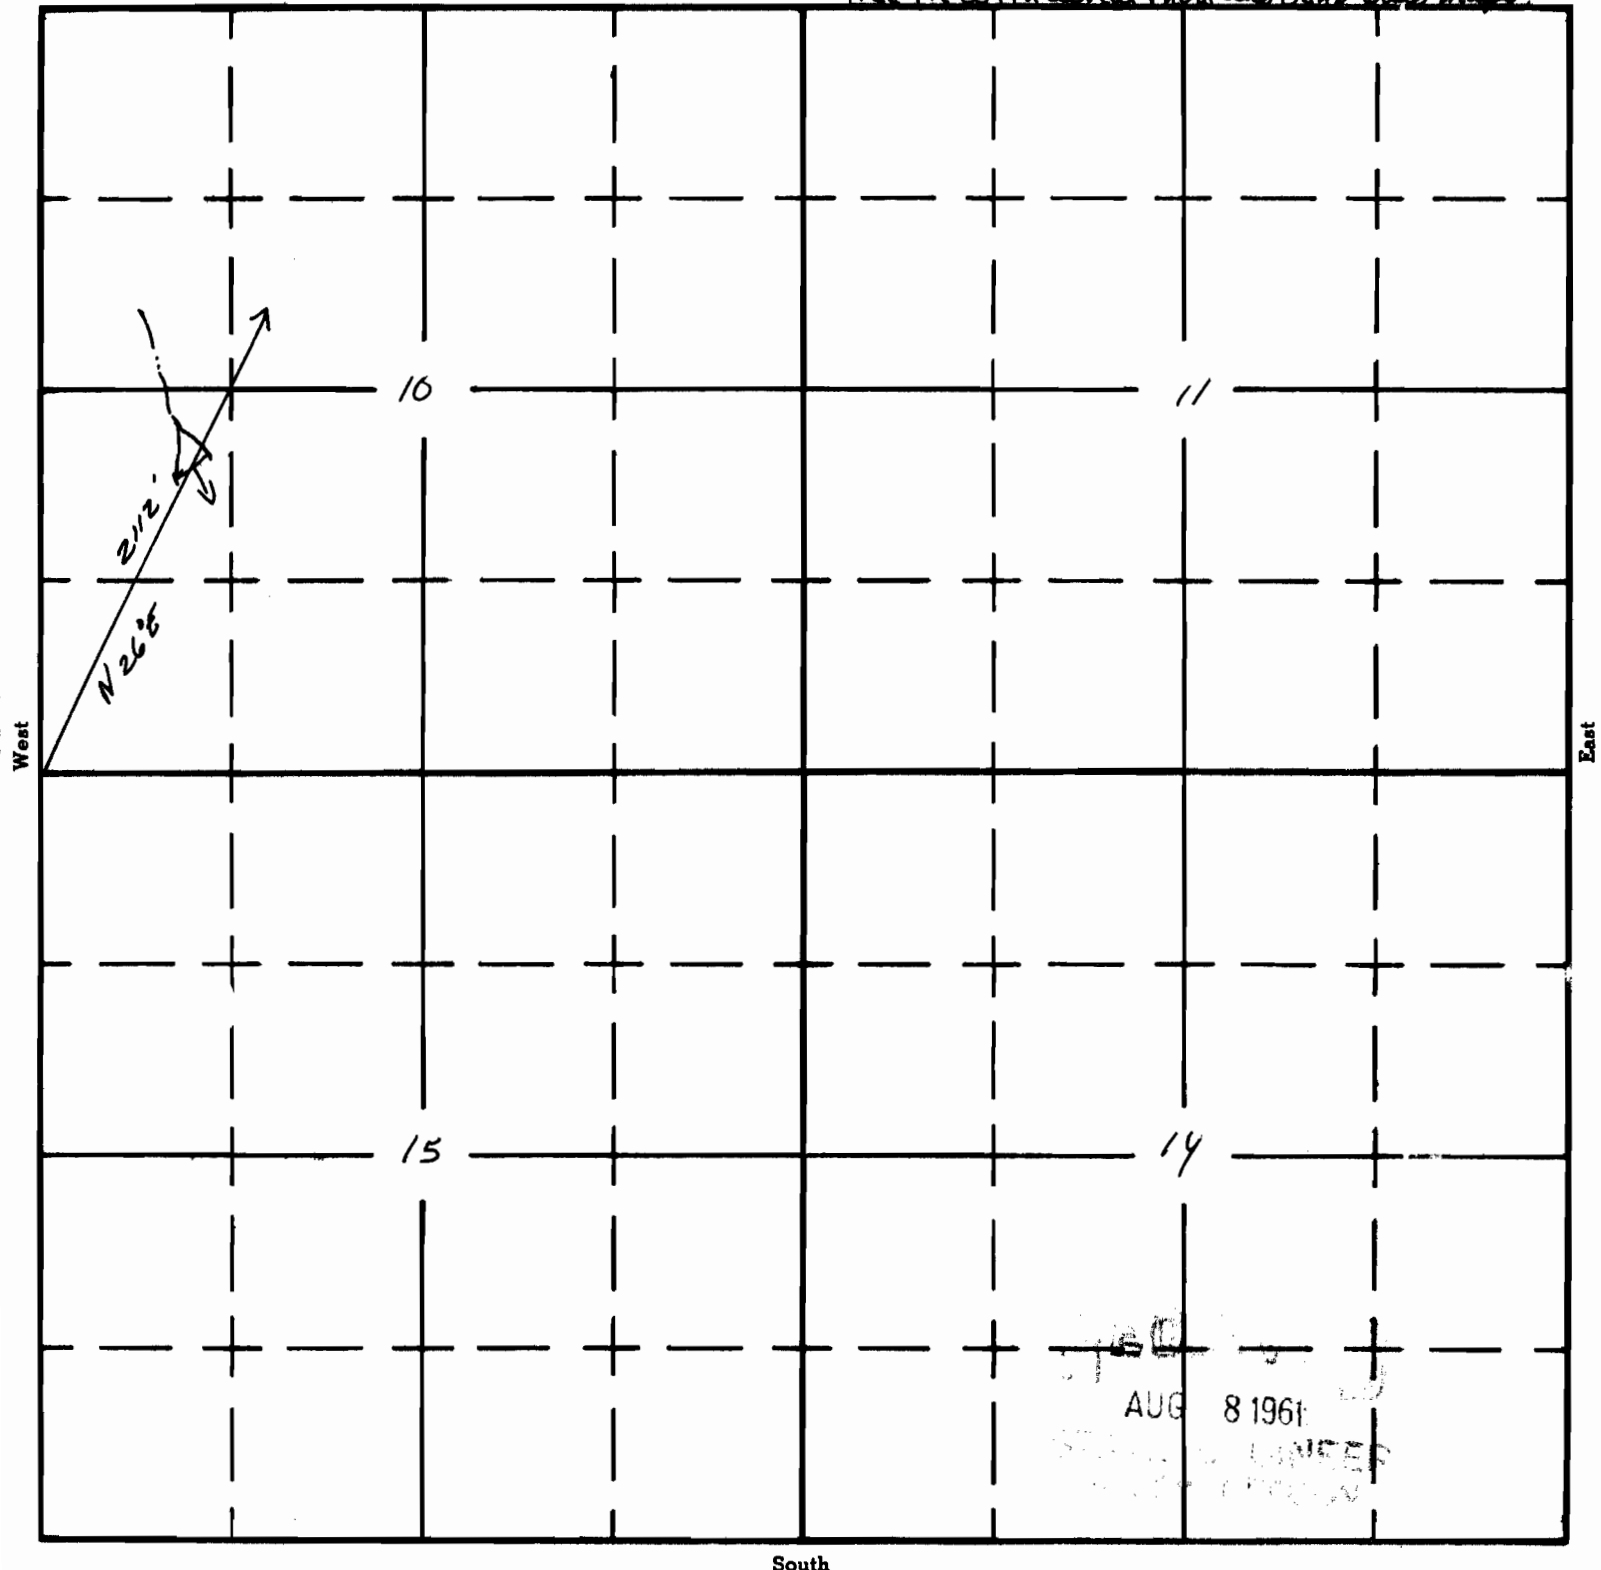

APPLICATION No. R-36556
PERMIT No. R 7235