

R-7355

Form A1-187
March 1961

UNITED STATES
DEPARTMENT OF THE INTERIOR
BUREAU OF LAND MANAGEMENT


SECTION 18

Oregon State Water Filings

78662

TOWNSHIP 29-S, RANGE 27-E, W. M.

North

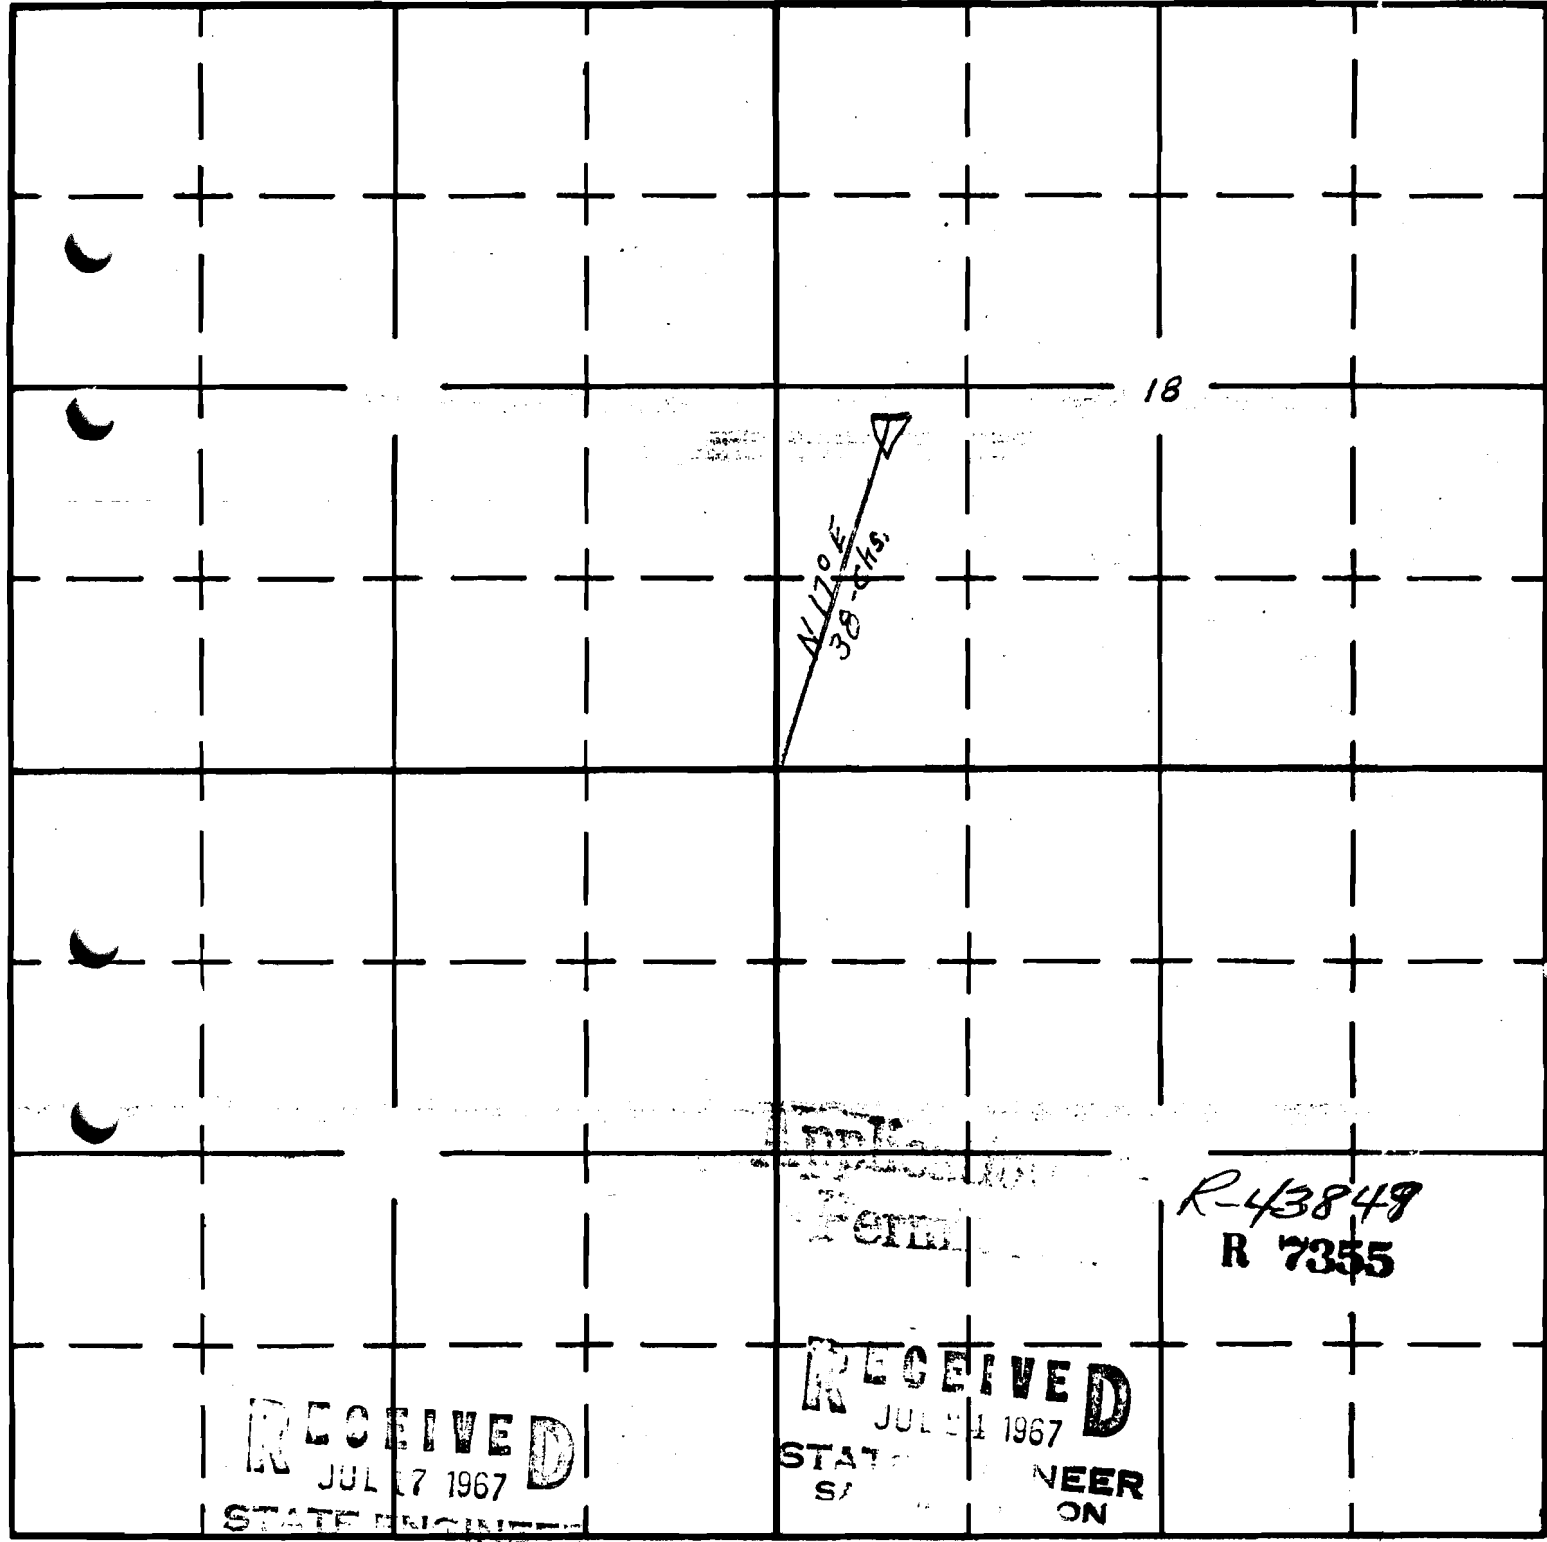

South

APPLICATION No.
PERMIT No.