


Form AI-187
March 1961

UNITED STATES
DEPARTMENT OF THE INTERIOR
BUREAU OF LAND MANAGEMENT

SECTION 3
NE 1/4, SW 1/4

Oregon State Water Filings
TOWNSHIP 29S, RANGE 18E, W. M.

North *Tied in with aerial photo and OSMD Quad Maps*

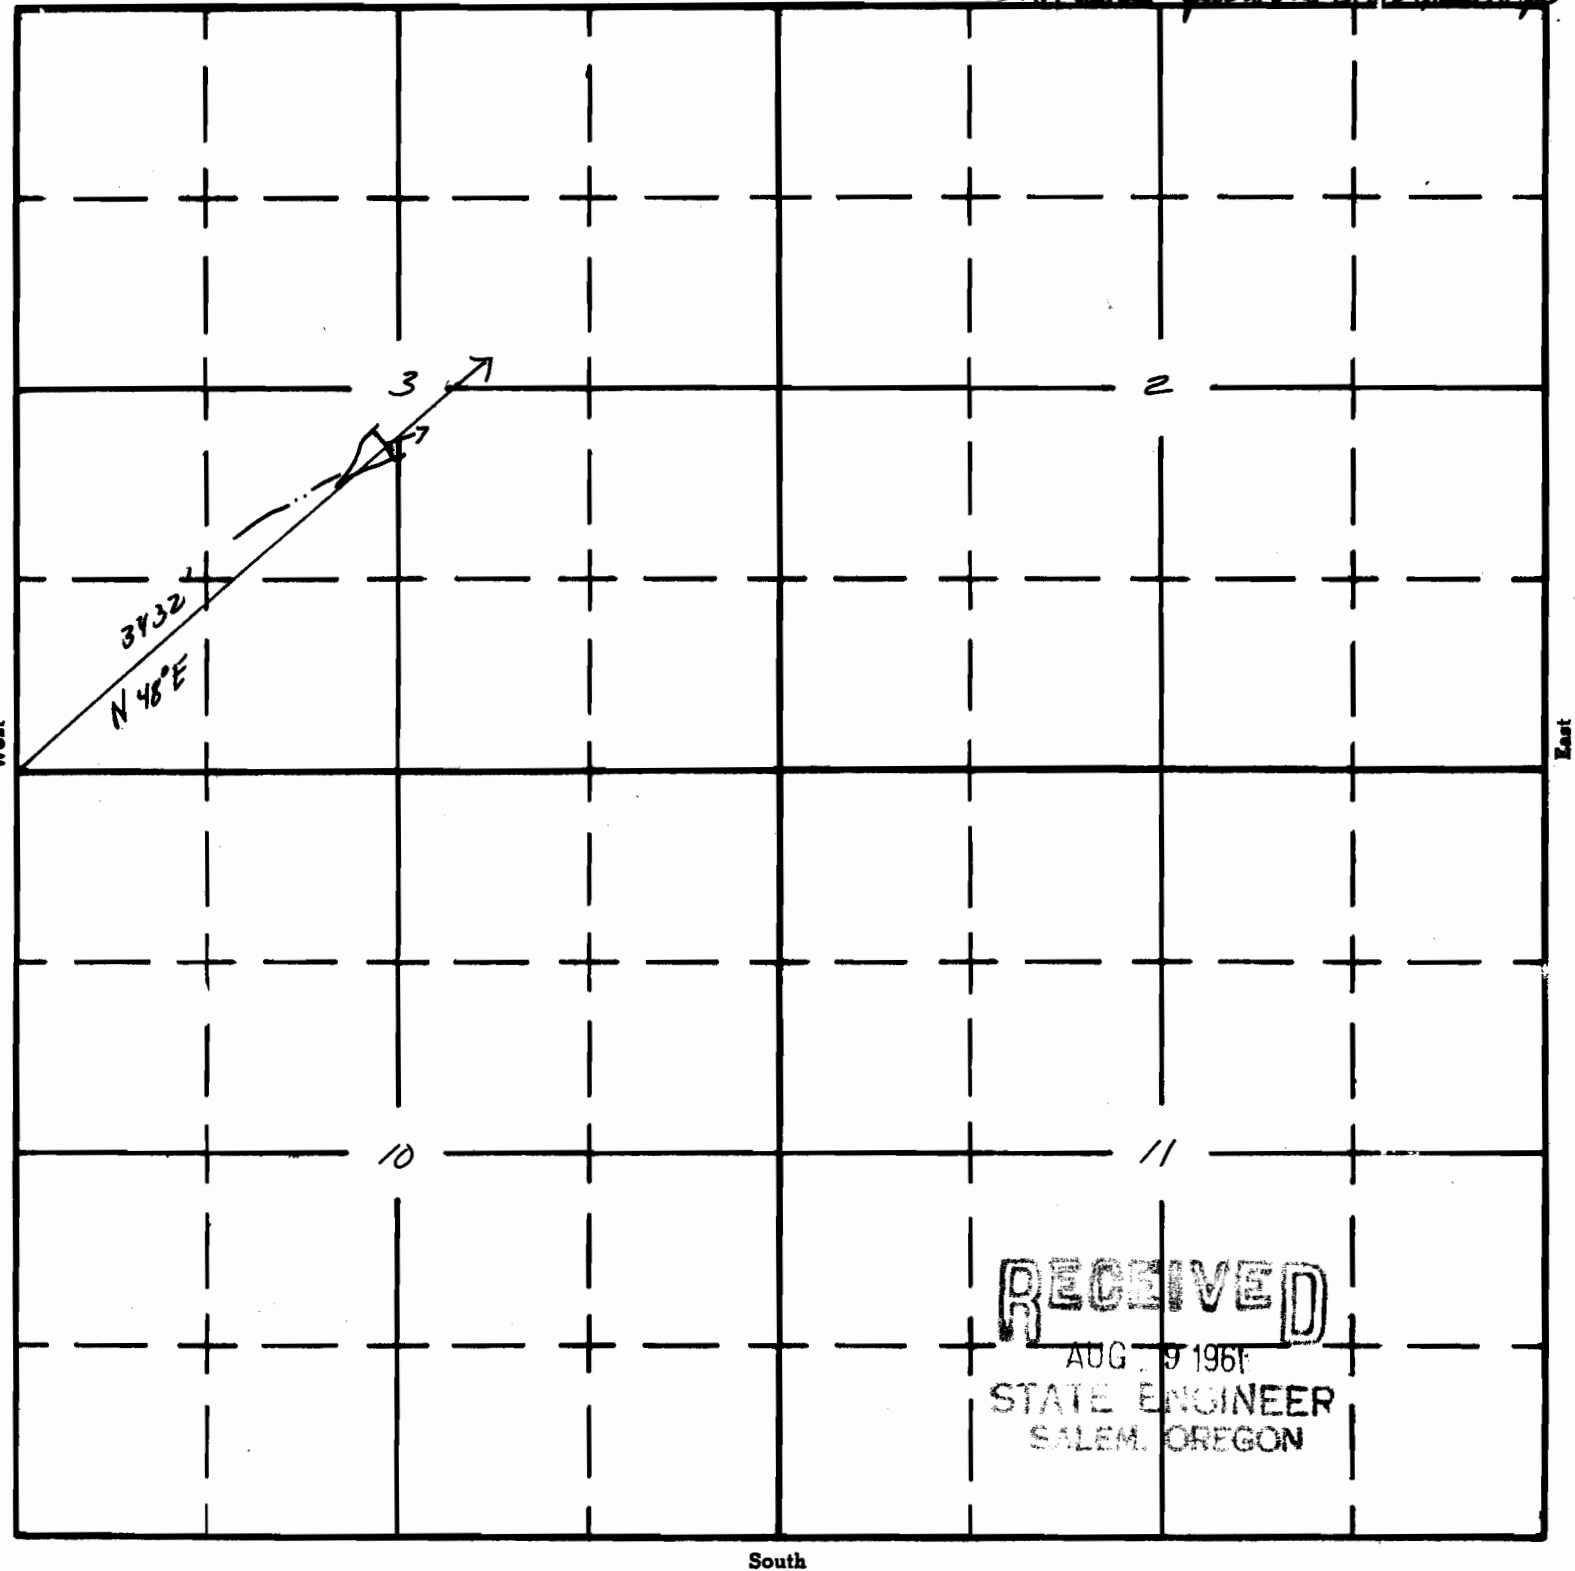

RECEIVED
AUG 9 1961
STATE ENGINEER
SALEM, OREGON

APPLICATION No. R-36959
PERMIT No. R 7361