


UNITED STATES
DEPARTMENT OF THE INTERIOR
BUREAU OF LAND MANAGEMENT

SECTION
NE 1/4, SW 1/4
SEC. 26

Oregon State Water Filings
TOWNSHIP 28S, RANGE 18E, W. M.

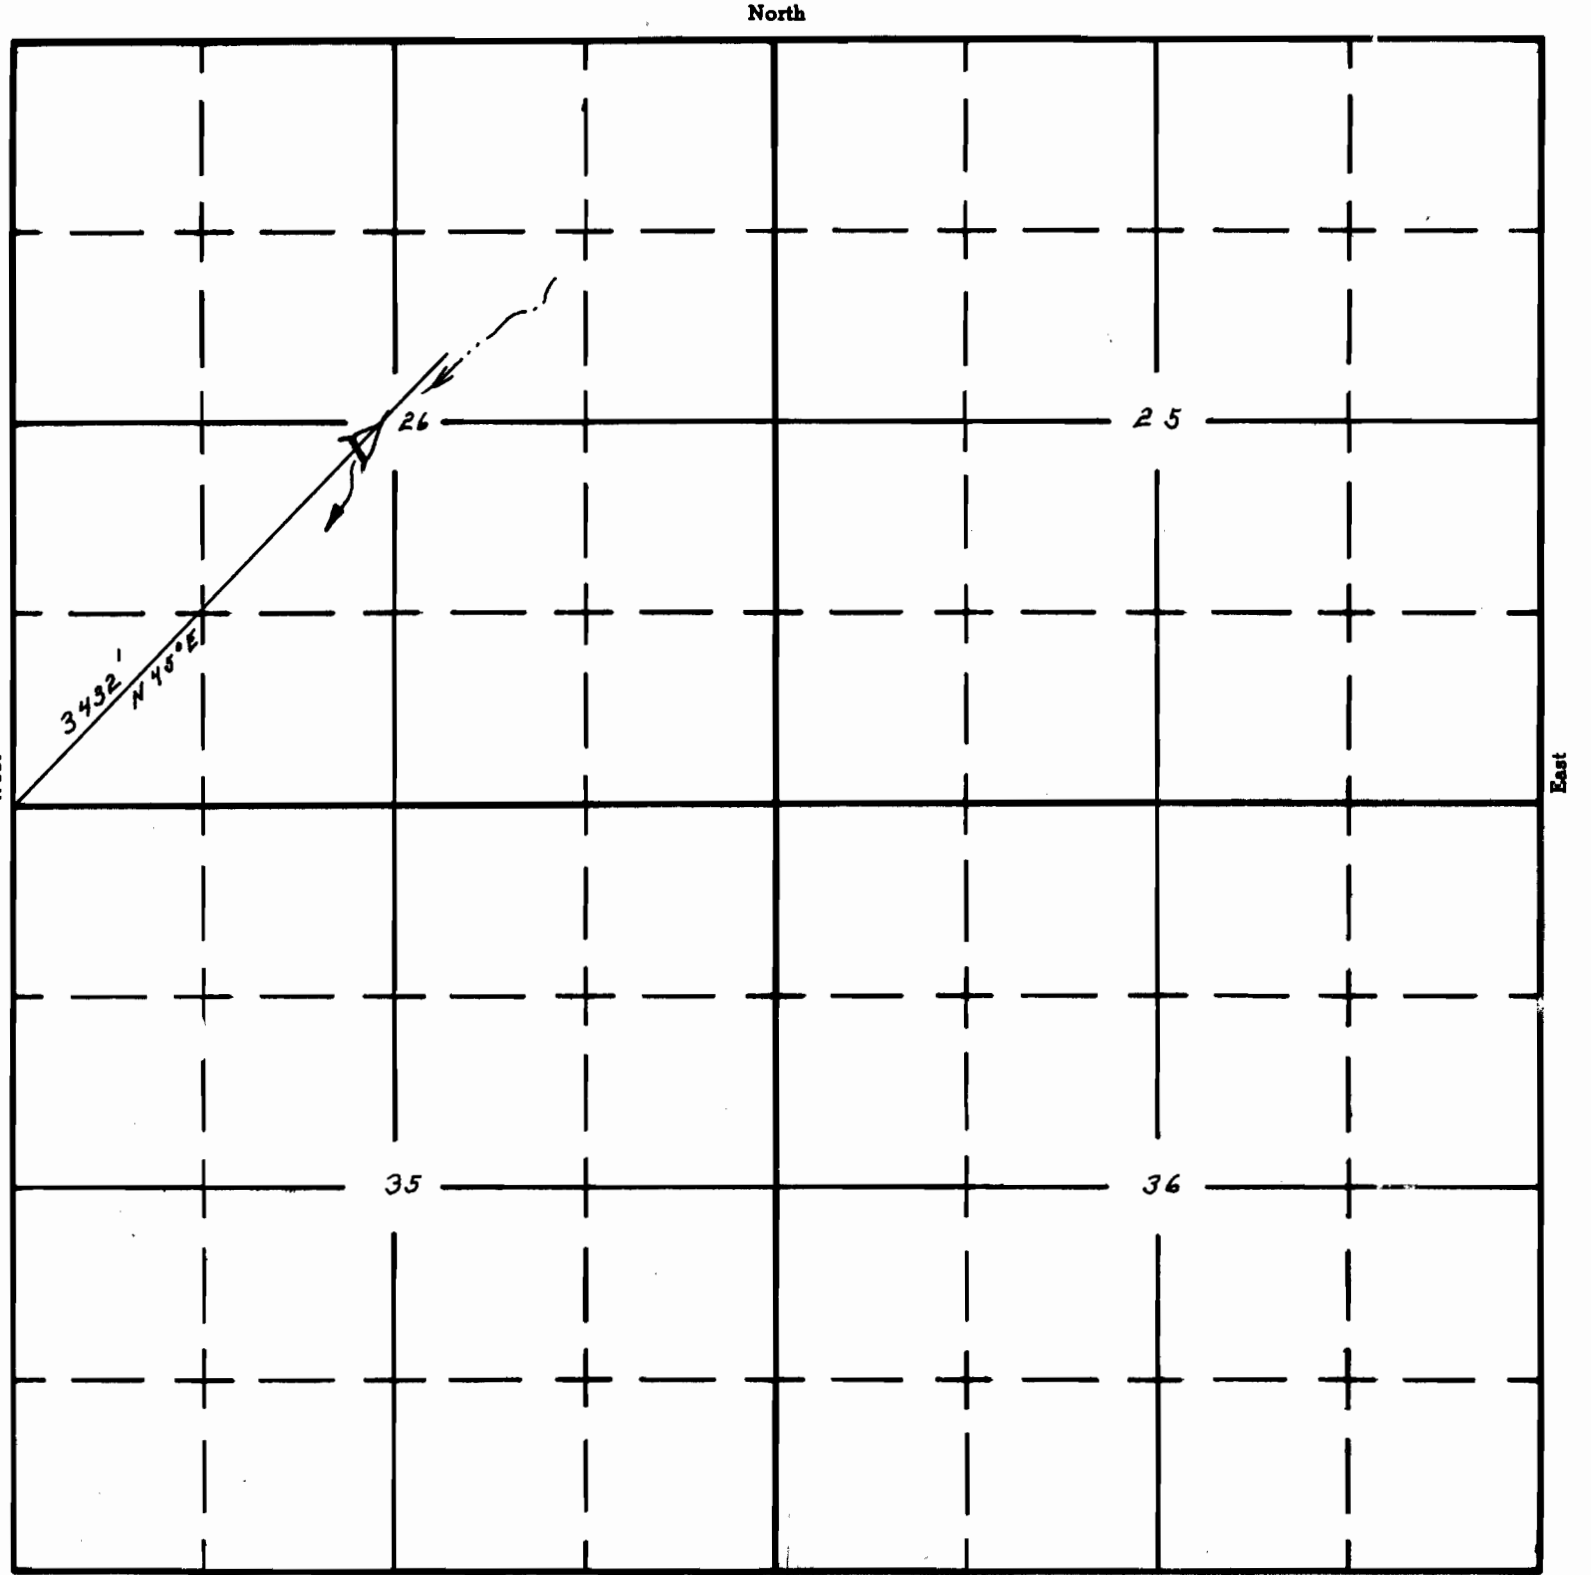

Sioux Reservoir 0-1-703

South DEC 10

APPLICATION No. R 36958
PERMIT No. 7365