

Form A1-187
March 1961

UNITED STATES
DEPARTMENT OF THE INTERIOR
BUREAU OF LAND MANAGEMENT


SECTION
31

Oregon State Water Filings

NW 1/4 NW 1/4

TOWNSHIP 38 S, RANGE 23 E, W. M.

Tied-in with AERIAL PHOTOS
North & O.S.H.D. QUAD MAPS.

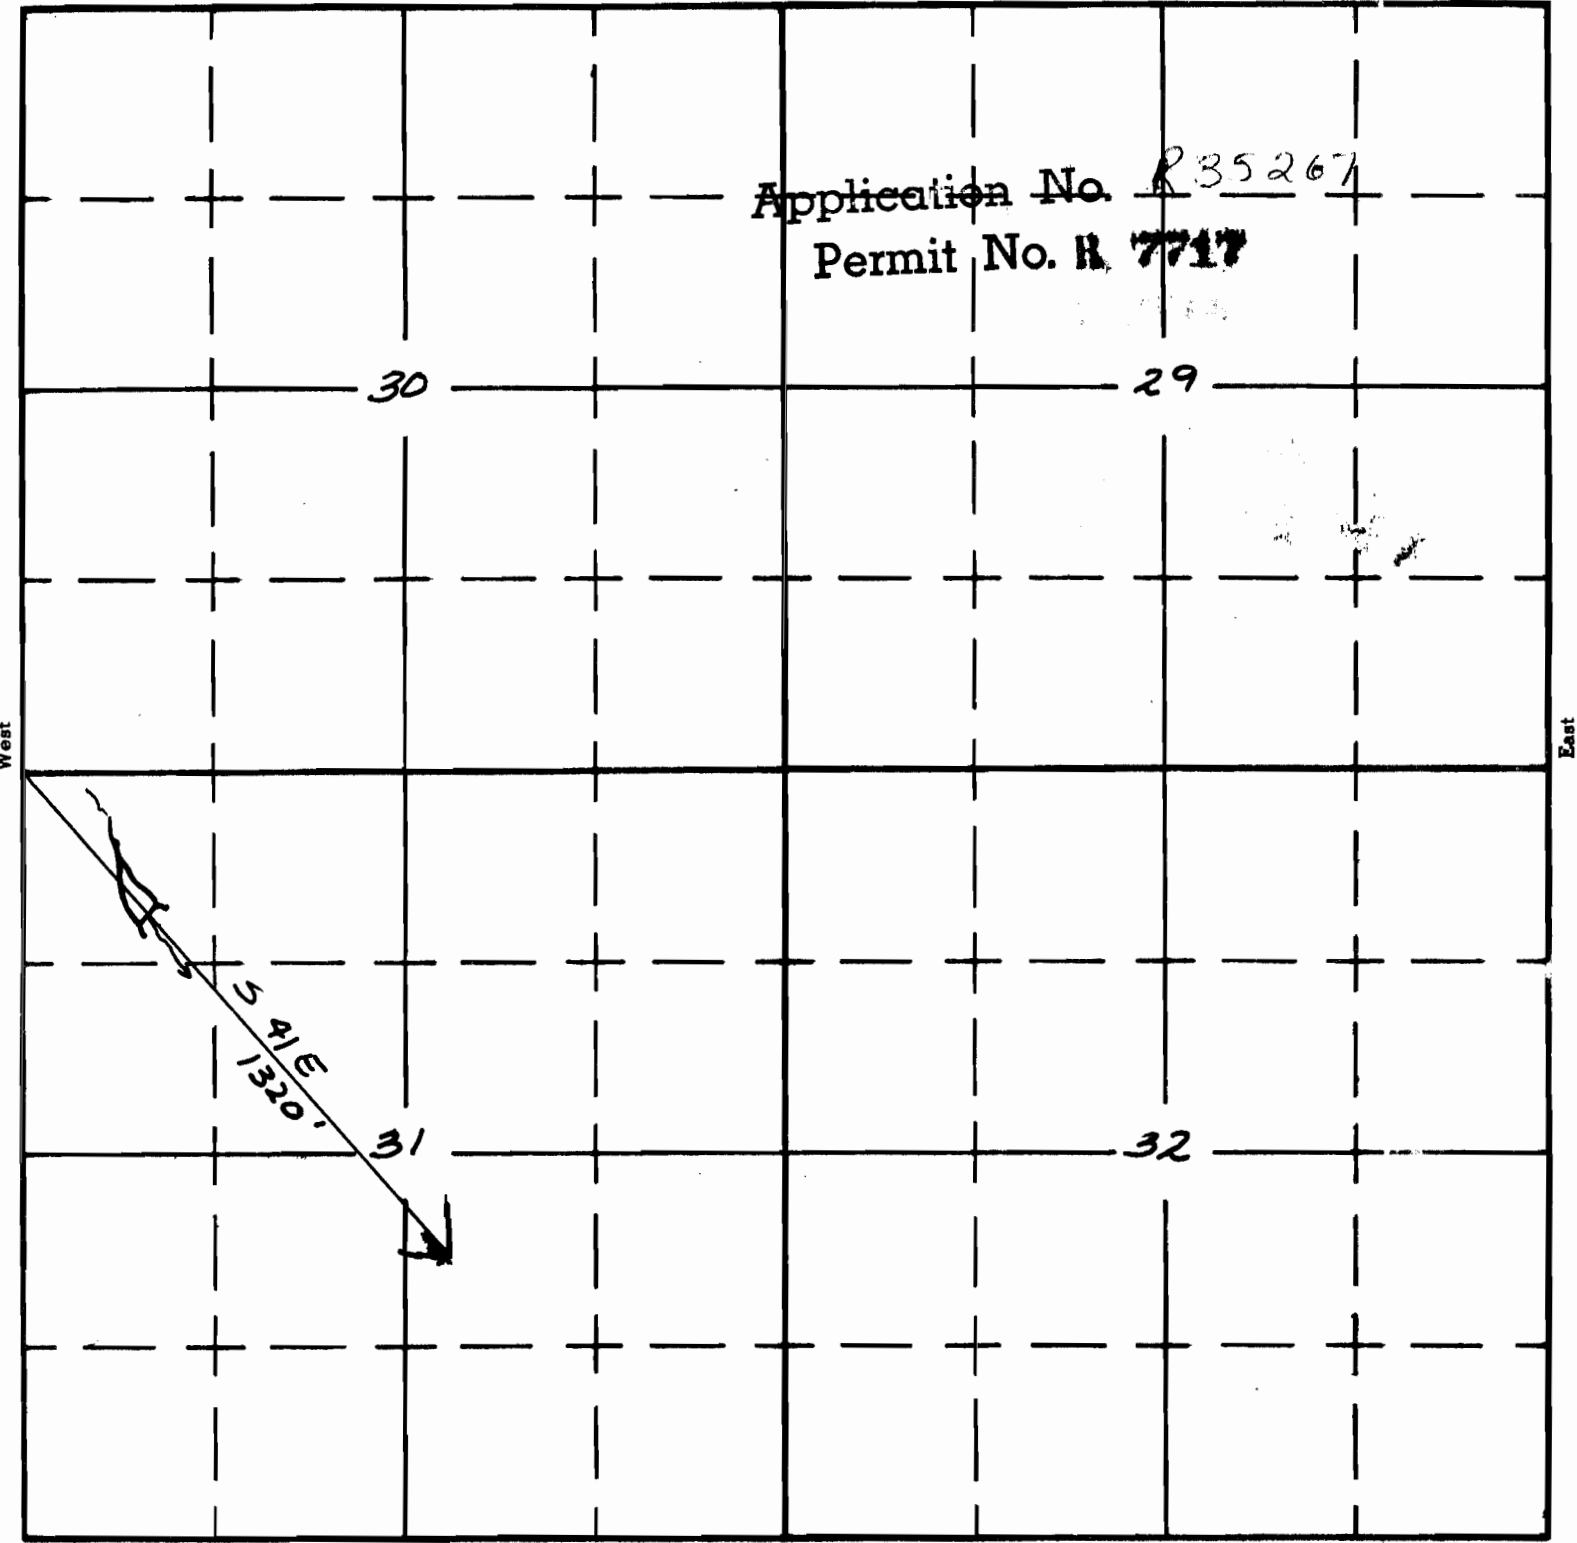

Application No. R 35267
Permit No. R 7717

APPLICATION No.
PERMIT No.