

R8945
78669

Form OR-010-7300-2
4/83

UNITED STATES
DEPARTMENT OF THE INTERIOR
BUREAU OF LAND MANAGEMENT


Section 8
SE NW

Township 31S.
Range 24E.

Appl. No. R-67363
Permit No. _____

Will. Mer.

Cross #1470

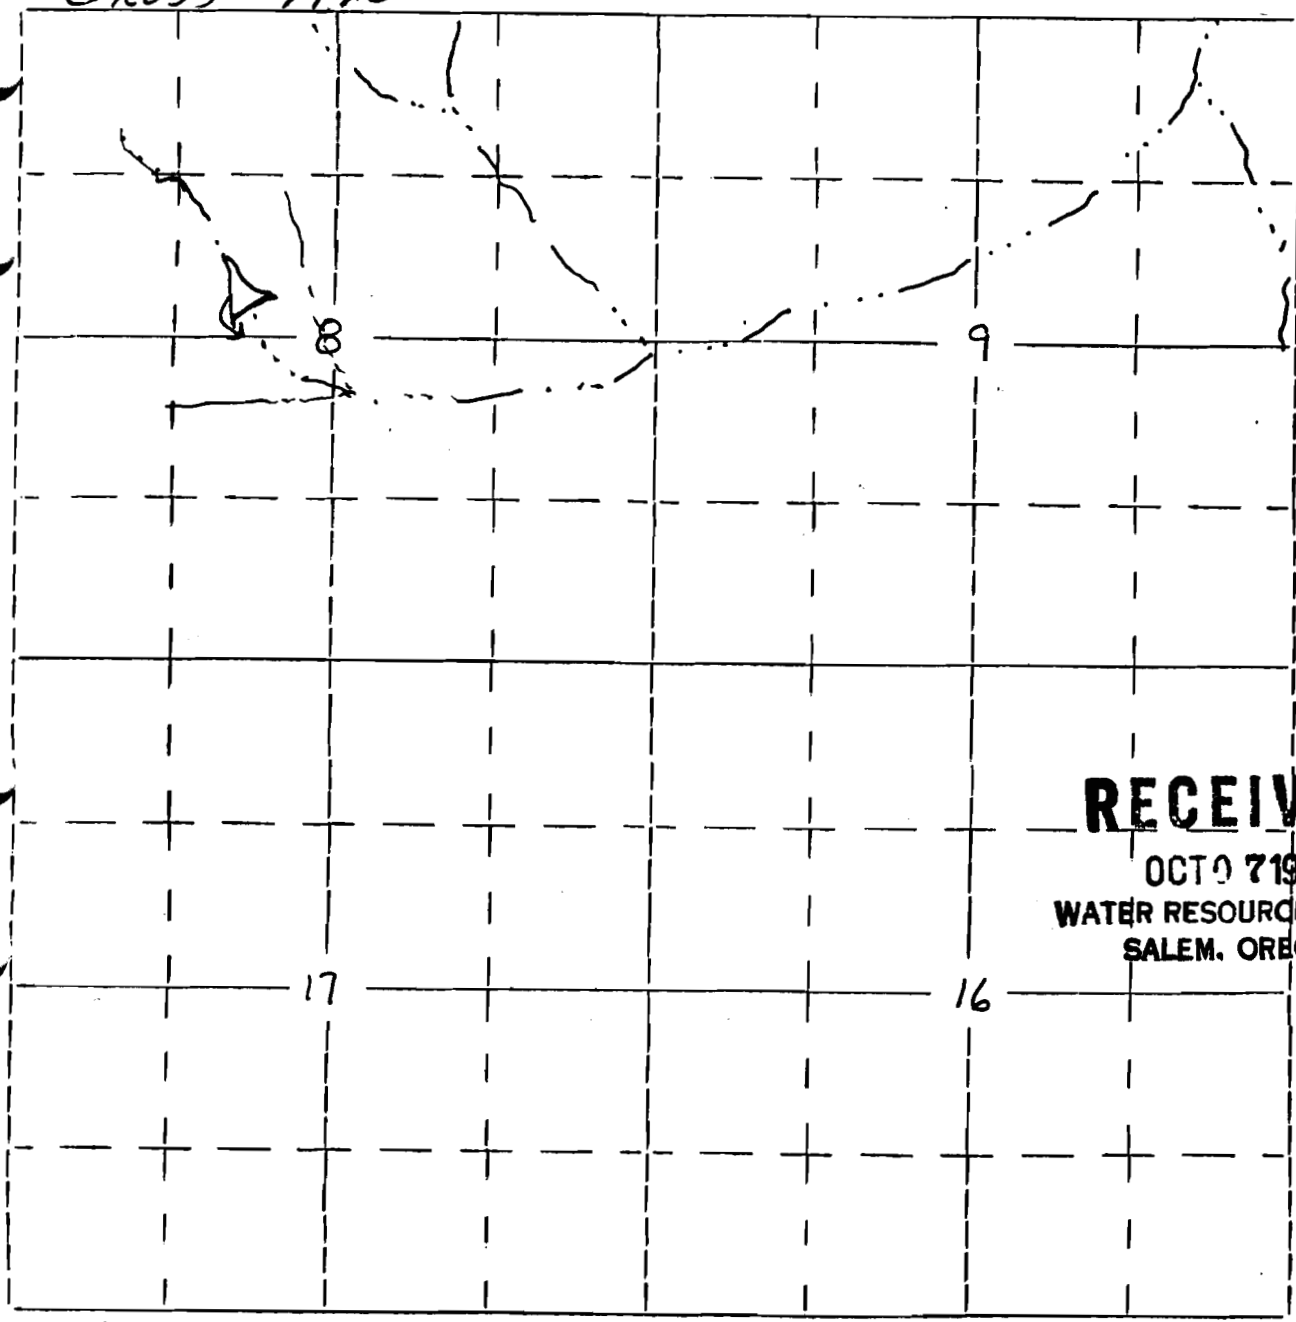

RECEIVED

OCT 9 7 1983
WATER RESOURCES DEPT.
SALEM, OREGON

2500' S. and 2000' E. of N.W. corner of Sec. 8.

Application No. R-67363
Permit No. R 8945