

R 8957
78670

Form OR-010-7300-2
4/83

UNITED STATES
DEPARTMENT OF THE INTERIOR
BUREAU OF LAND MANAGEMENT

Section 23

Township 35S

Appl. No. R-67377


SW NE

Range 21E

Permit No. R 8957

Will. Mer.

Shrew Reservoir (#497)

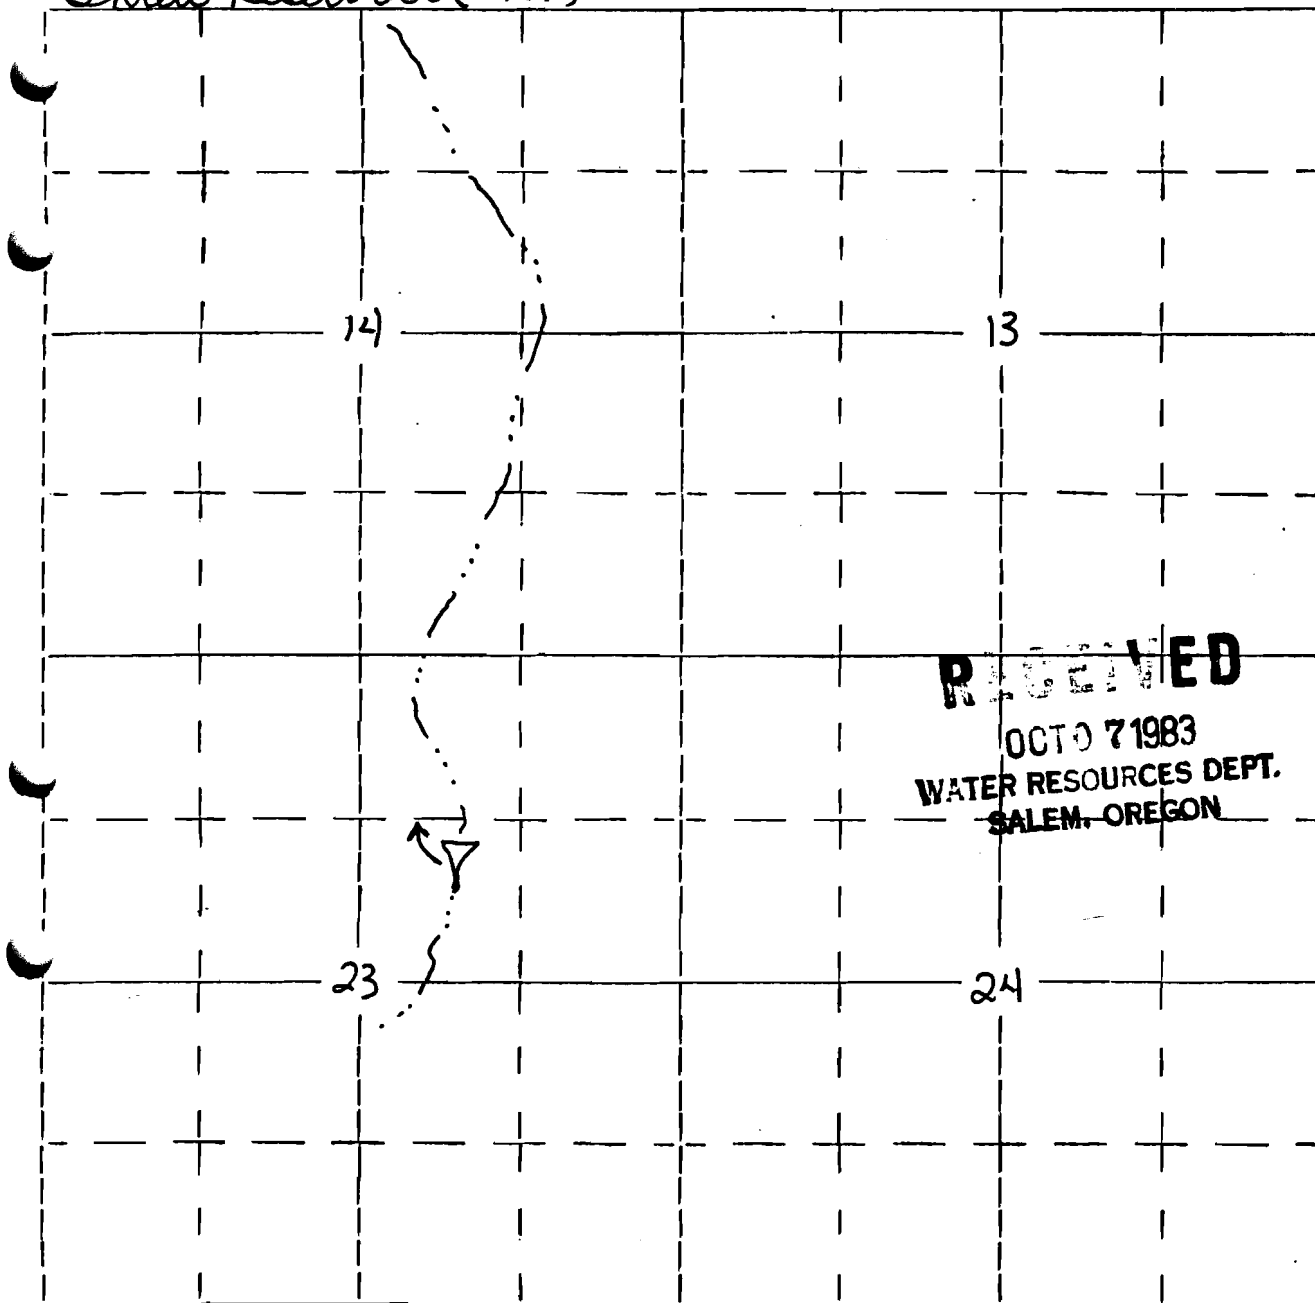

2000'S, 1800'W of NE corner of section 23