

R8965
78671

Form OR-010-7300-2
4/83

UNITED STATES
DEPARTMENT OF THE INTERIOR
BUREAU OF LAND MANAGEMENT

Section

22

Township 28S

Appl. No. R-67387

NE NW


Range 24E

Permit No. R 8965

Will. Mer.

Brush Knoll W.H. 1555

RECEIVED
OCT 9 7 1983
WATER RESOURCES DEPT.
SALEM, OREGON

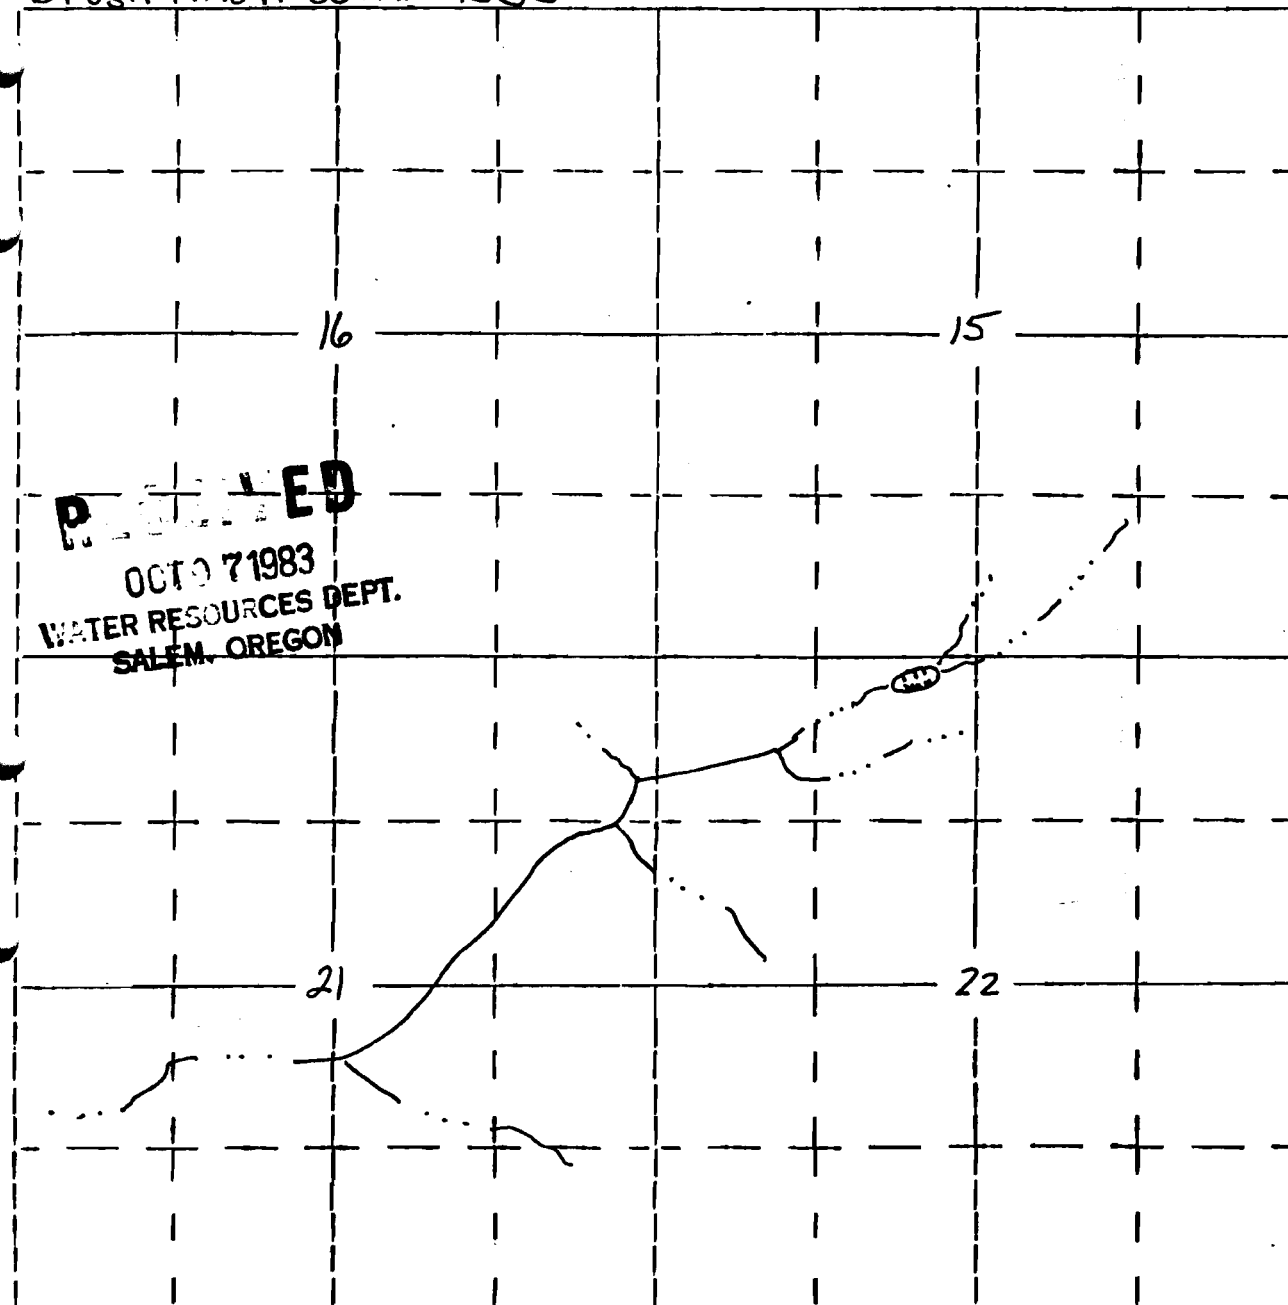

150'S 2500'E of the NW corner of section 22