

R 8970
78672

Form OR-010-7300-2
4/83

UNITED STATES
DEPARTMENT OF THE INTERIOR
BUREAU OF LAND MANAGEMENT

Section 15
NW NE

Township 36 S


Range 29 E

Appl. No. R-67392

Permit No. R 8970

Will. Mer.

Section Line Reservoir 5188

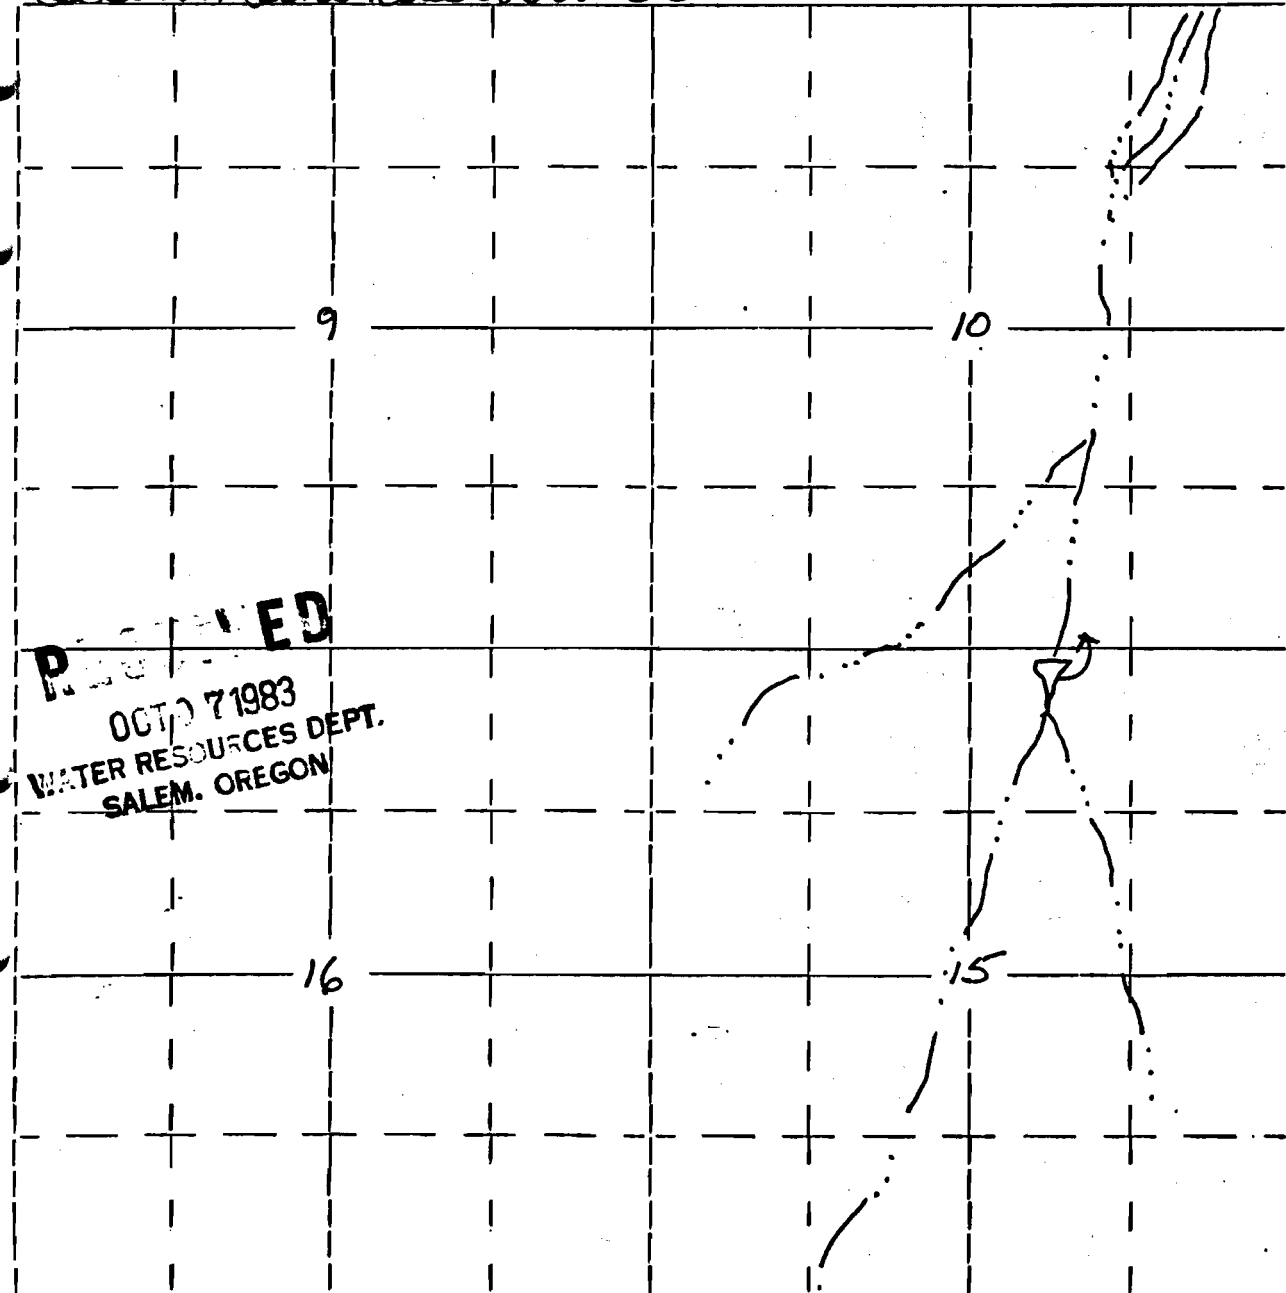

200'S, 1800'E of NW corner of section 15