

R 8971
78673

Form OR-010-7300-2
4/83

UNITED STATES
DEPARTMENT OF THE INTERIOR
BUREAU OF LAND MANAGEMENT


Section 14
SWNE

Township 39S
Range 26E

Appl. No. R-67393
Permit No. R 8971

Will. Mer.

Cliff Waterhole #1096

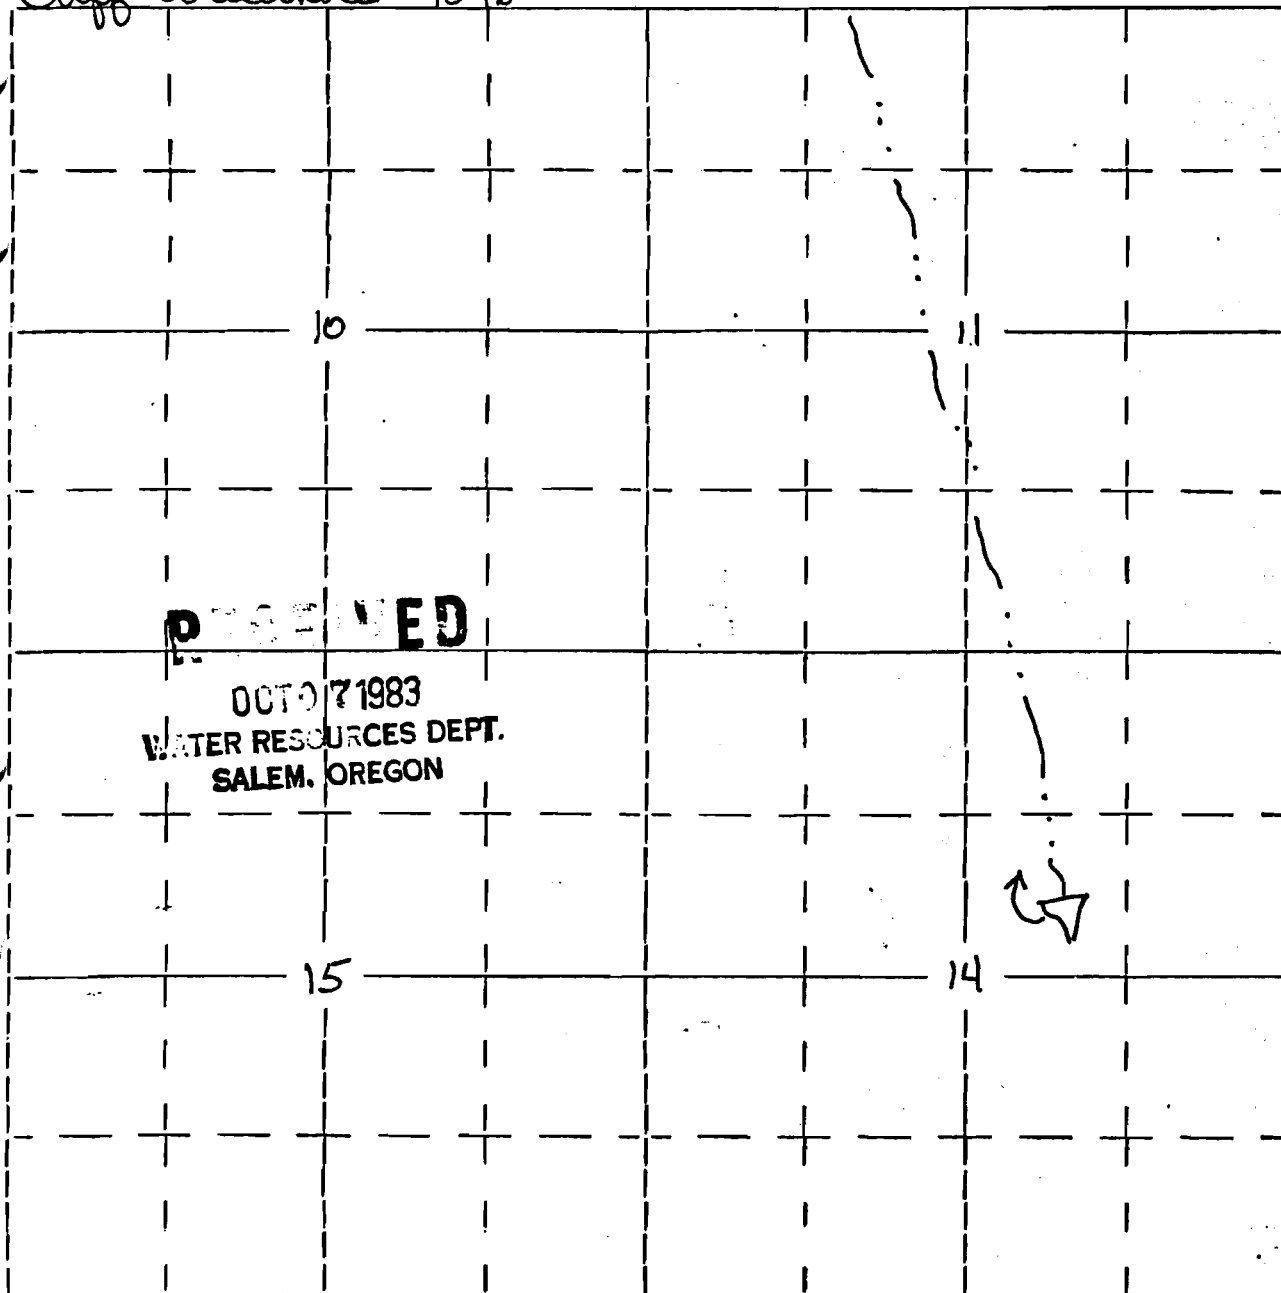

2250'S, 1950' W of the NE corner of section 14