

R8978
78674

Form OR-010-7300-2
4/83

UNITED STATES
DEPARTMENT OF THE INTERIOR
BUREAU OF LAND MANAGEMENT

Section

2

Township 39S

Appl. No. R-67401


SWSW

Range 23E

Permit No. R 8978

Will. Mer.

FLOOD RES. 4471

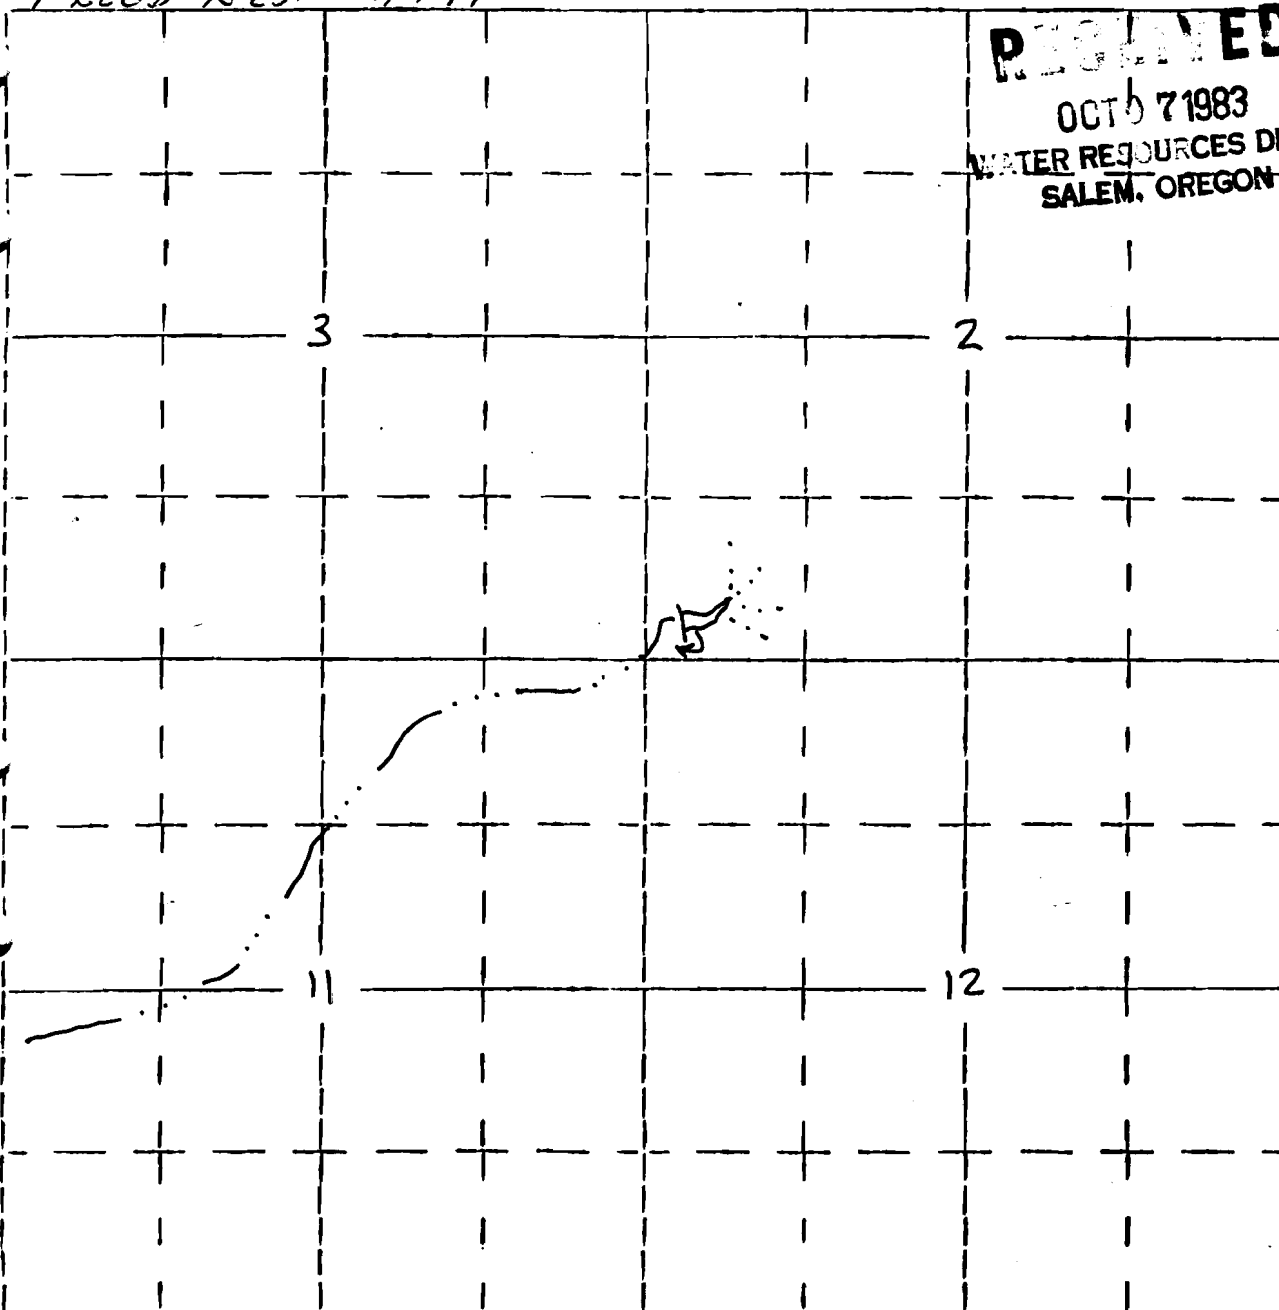

250' N 300' E of the SW corner of section 2